
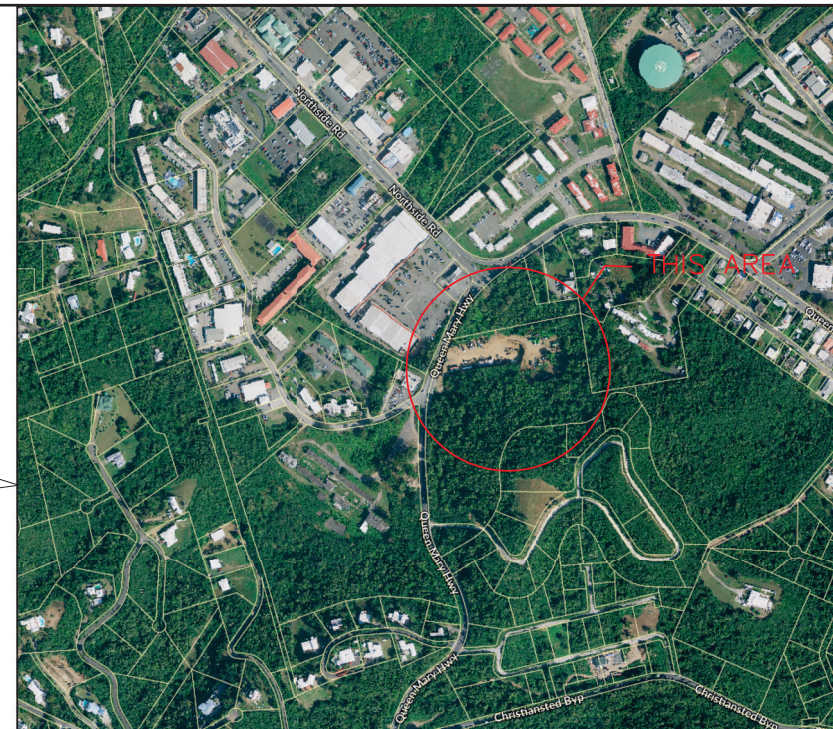


ALL WORK COMPLY TO THE FOLLOWING CODES
 INTERNATIONAL RESIDENTIAL CODES (IRC) 2021
 INTERNATIONAL BUILDING CODE (IBC) 2021
 NATIONAL ELECTRICAL CODES (NEC) 2020
 UNIFORM PLUMBING CODES (UPC) 2021

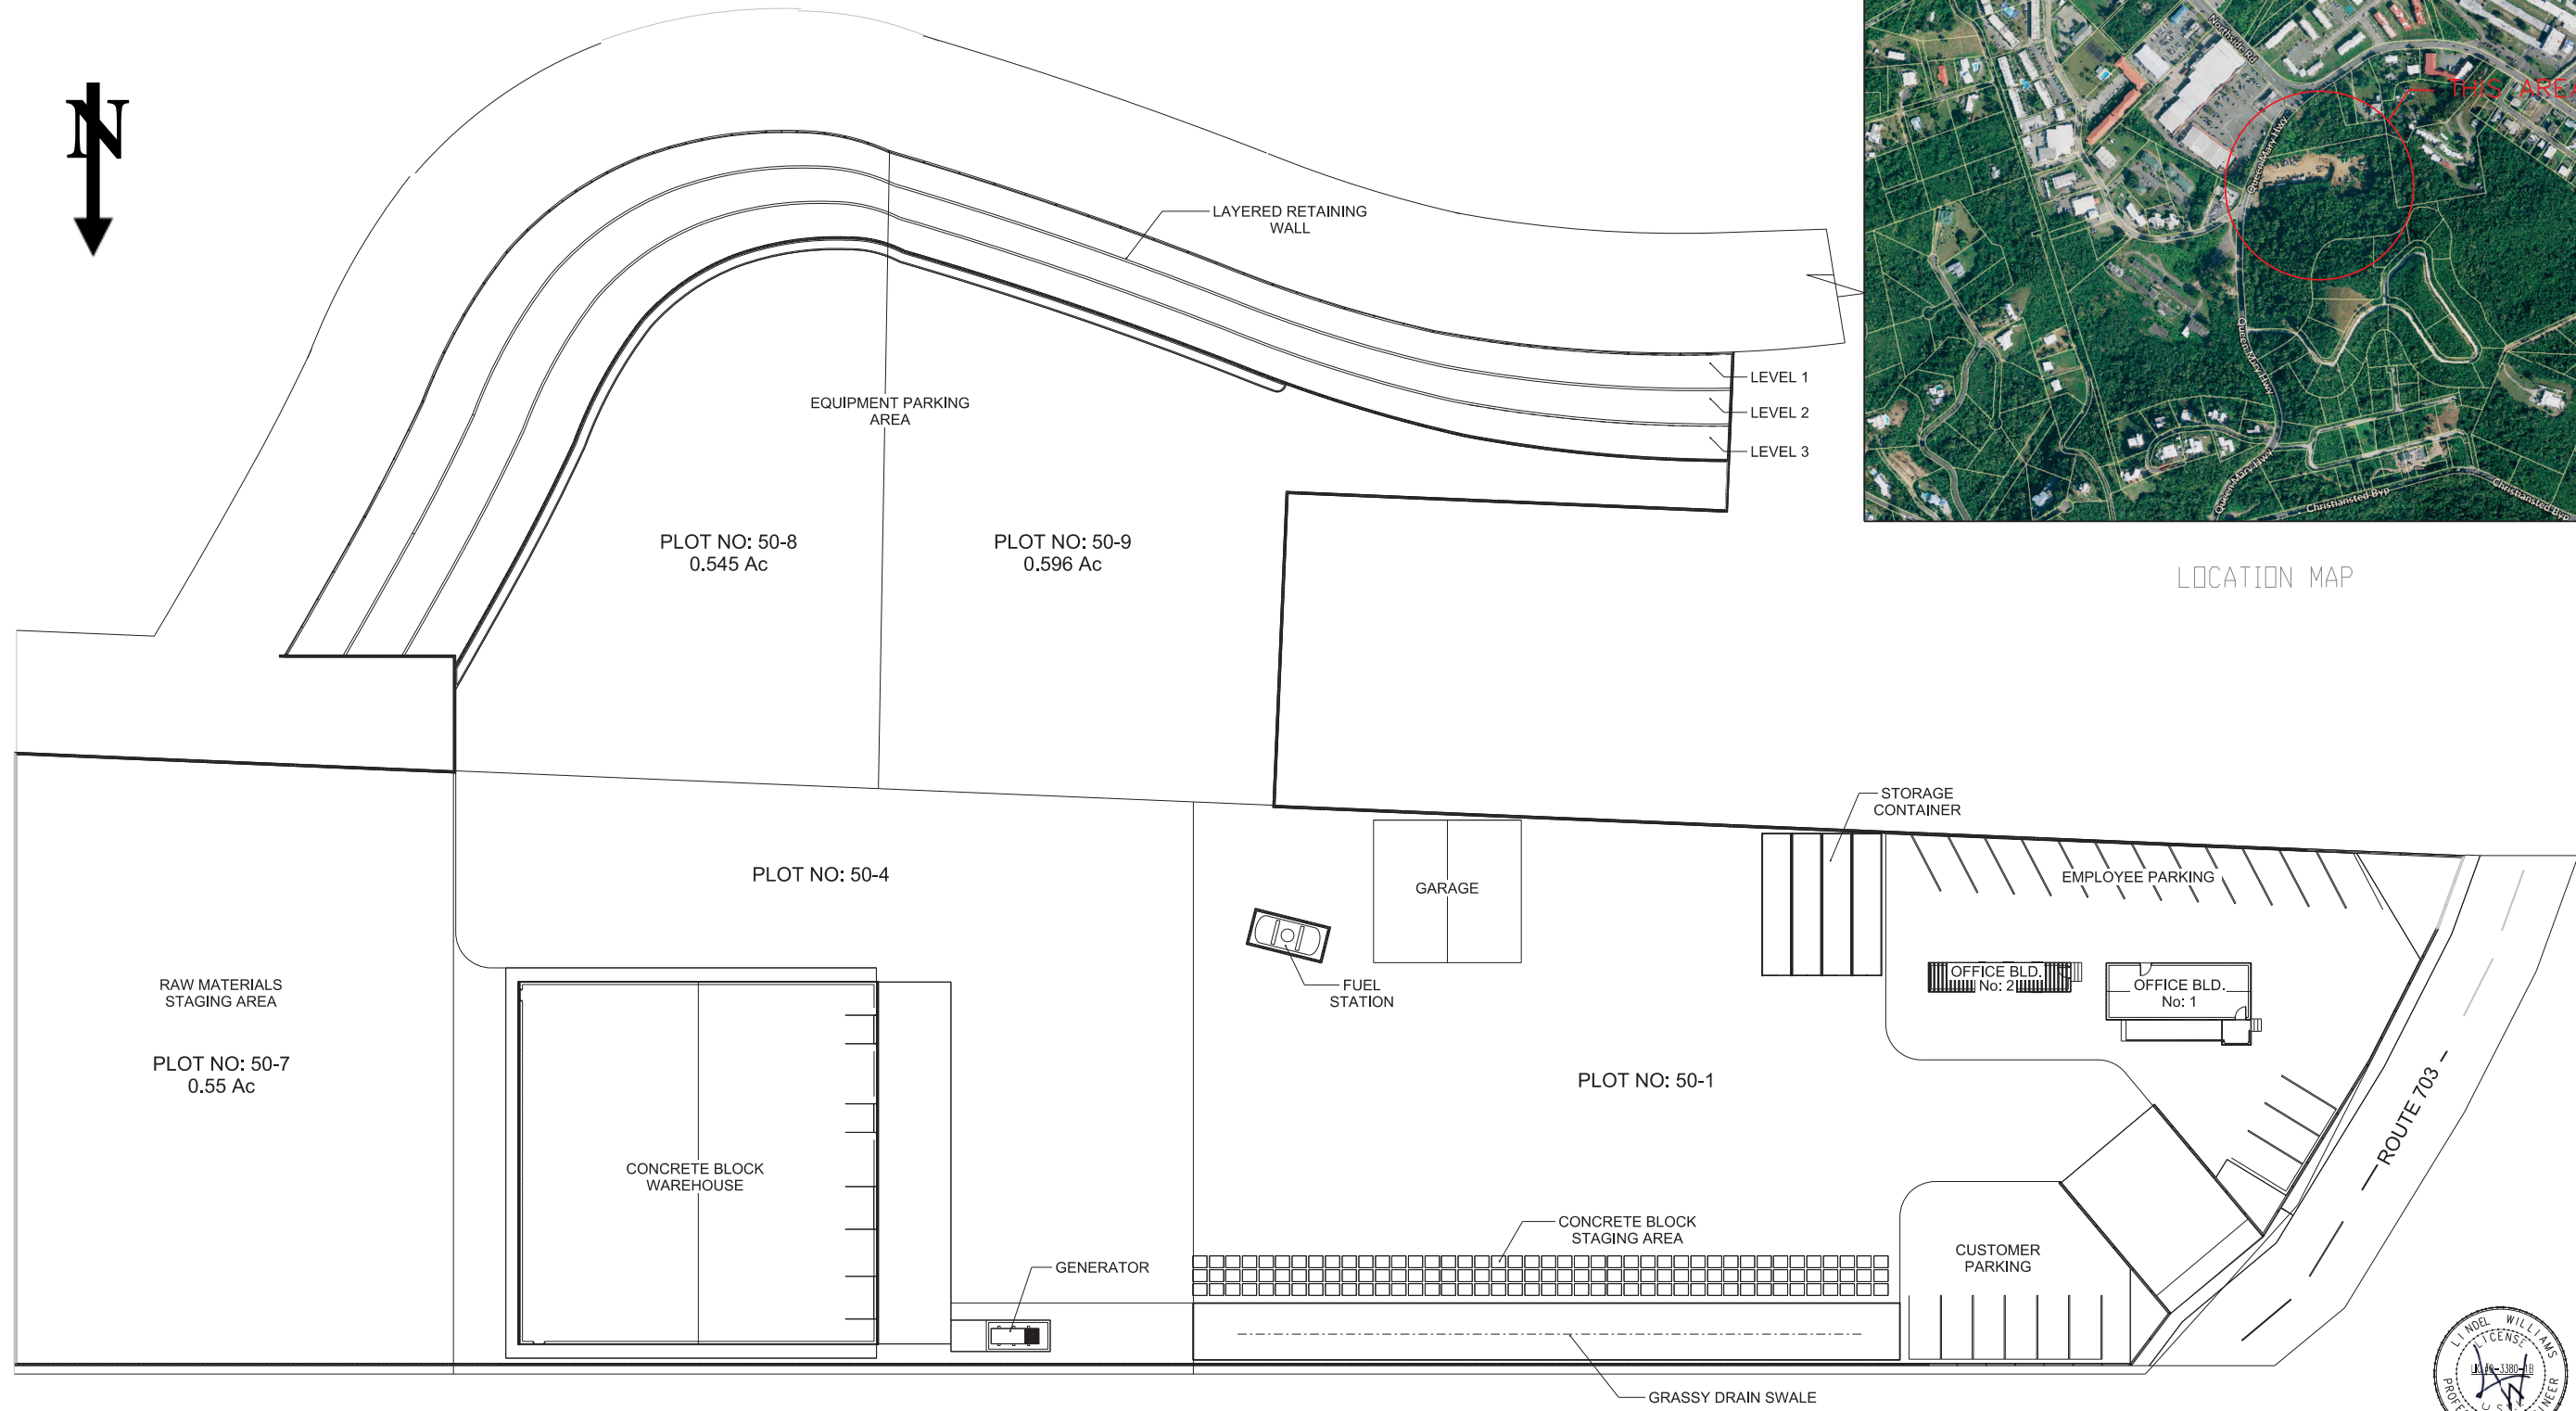

LOCATION MAP

Name: CALVIN RICHARDS
 Signature: *Calvin Richards*
 Date: _____
 License No. 2-6266-1L

CONSTRUCTION DOCUMENT PLOT PLAN
 SCALE: AS NOTED
 OWNER: JUST RIGHT TRUCKING
 PLOT # ORANGE GROVE 50-1,50-4,50-7,....
 ST. CROIX U.S. VIRGIN ISLAND KING QUARETR

DESIGN ENGINEERING
 Architectural/ Industrial Design and Construction Consultation
 PO Box 1872
 Kingshill, VI 00851
 PH: 340-6908759

DRAWN BY	CALVIN RICHARDS
CHECKED BY	CALVIN RICHARDS
DATE	
DATE	REVISION
PLAN NUMBER	
SHEET NUMBER	

