

REF. (B9-452-176)


LEGEND

- CONC BOUND POST FD
- 4" PIPE BOUND POST FD
- 4" PIPE BOUND POST FD
- ▲ UNMARK POINT
- † PROPERTY LINE
- UTILITY POLE
- ⊙ SEWER MANHOLE

THIS IS TO CERTIFY THAT THIS MAP AND SURVEY ON WHICH IT IS BASED WERE MADE IN ACCORDANCE WITH THE 2021 MINIMUM STANDARD DETAIL REQUIREMENTS FOR ALTA/MAPS LAND TITLE SURVEY ACCORDANCE WITH THE 2021 MINIMUM STANDARD DETAIL REQUIREMENTS FOR LAND TITLE SURVEYS JOINTLY ESTABLISHED AND ADOPTED BY A.L.T.A./N.S.P.'S LAND TITLE SURVEYS AND I FURTHER CERTIFY THAT THE BOUNDARIES OF THE SURVEYED PARCEL OF LAND AND ALL ENCROACHMENTS, IF ANY ARE AS SHOWN ON THIS SURVEY MAP

COMPLETED ON DATE 3/30/2024
 DATE OF MAP 3/30/2024

Wayne D Callwood
 WAYNE D CALLWOOD PE

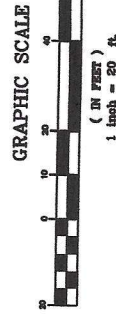

SURVEY REF. FILE NO. (B9-452-T75)

Wayne D. Callwood, P.E.
 Architects-Engineers & Land Surveyors,
 Consulting, General Contracts & Estimates

"AS BUILT SURVEY" OF PARCEL NO. 4 EST. CHARLOTTE AMALIE	
DATE	APPROVED BY
3/30/2024	W.D.C
SCALE 1" = 40'	
DRAWN BY	
W.D.C	
NO. 3 NEW QUARTER ST. THOMAS, U.S.V.I.	
SHEET #	DRAWING #
	170638