




TD APPROVED AS NOTED

3/23/16


* PENDING MEP
COORDINATION

NO SPRINKLERS

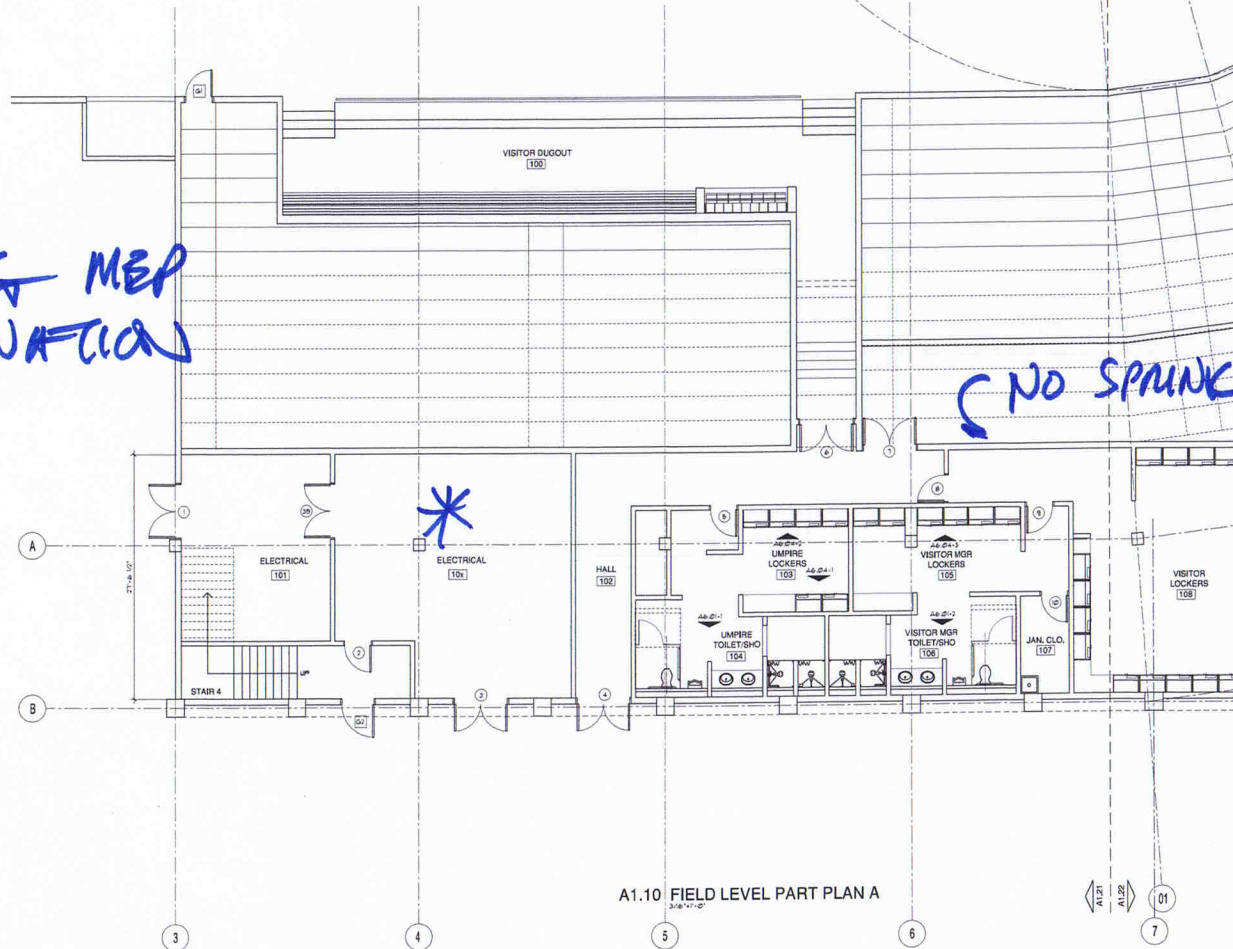


A1.10 FIELD LEVEL PART PLAN A
3/16/16

0 2 4 8 16
SCALE: 3/16" = 1'-0"

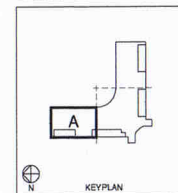

PROGRESS SET 03.22.16

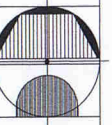

Steven E. Hutchins AIA Architects
109-113 ESTATE CASTLE COAKLEY
CHRISTIANSTEDT, ST. CROIX
U.S. VIRGIN ISLANDS 00822
TEL. 340-778-8898 FAX 340-778-7754


PROJECT:
FREDERIKSTEDT REVITALIZATION PROJECT
PAUL E. JOSEPH BASEBALL STADIUM
AND SPORT COMPLEX

DRAWING INFORMATION
FIELD LEVEL PART PLAN 'A'

DATE:
DRAWN BY:


SHEET NUMBER:

A1.21

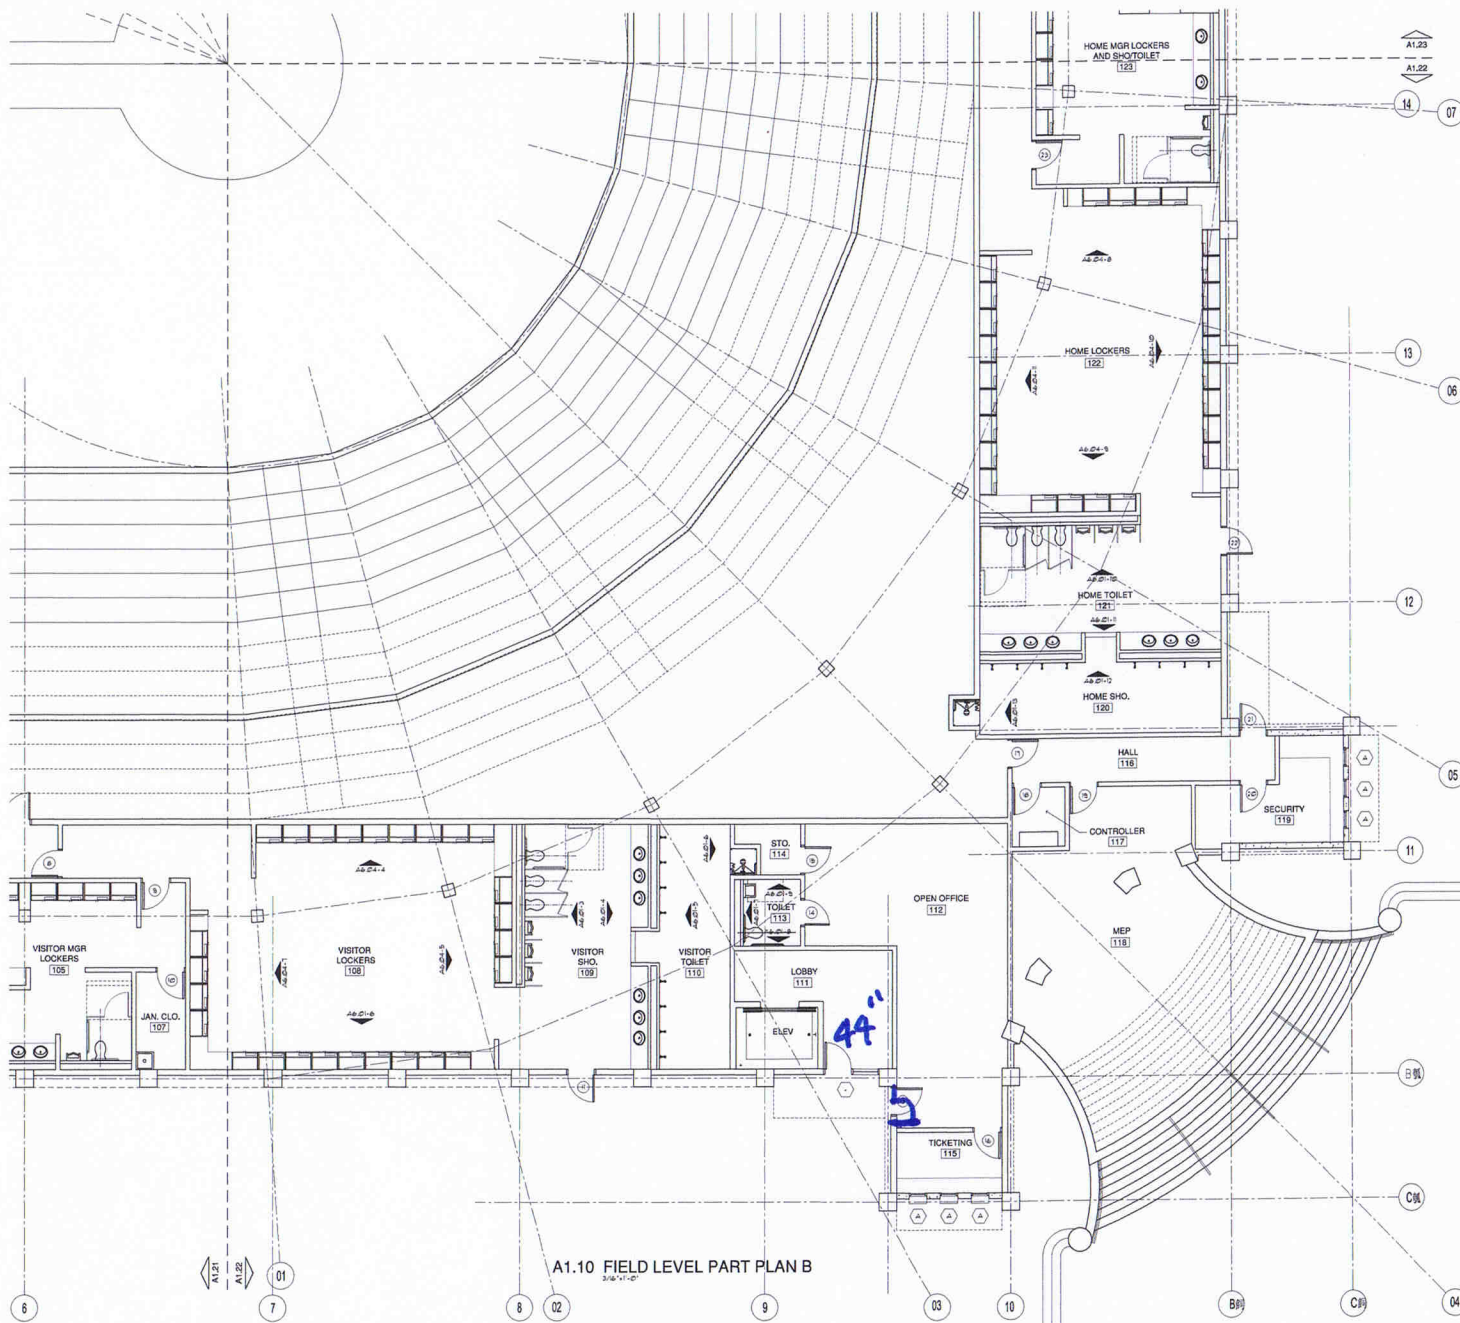

A1.10 FIELD LEVEL PART PLAN B
3/16" = 1'-0"

0 2 4 8 16
SCALE: 3/16" = 1'-0"

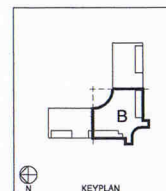


DRAWING INFORMATION

FIELD LEVEL PART PLAN 'B'

DATE:
DRAWN BY:

SHEET NUMBER:

A1.22

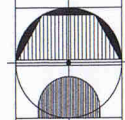


Steven E. Hutchins AIA Architects
109-113 ESTATE CASTLE OAKLEY
CHRISTIANSTED, ST. CROIX
U.S. VIRGIN ISLANDS 00822
TEL. 340-778-6888 FAX 340-778-7754

FREDERIKSTED REVITALIZATION PROJECT
PAUL E. JOSEPH BASEBALL STADIUM
AND SPORT COMPLEX


PROGRESS SET 03.22.16

20 of 10

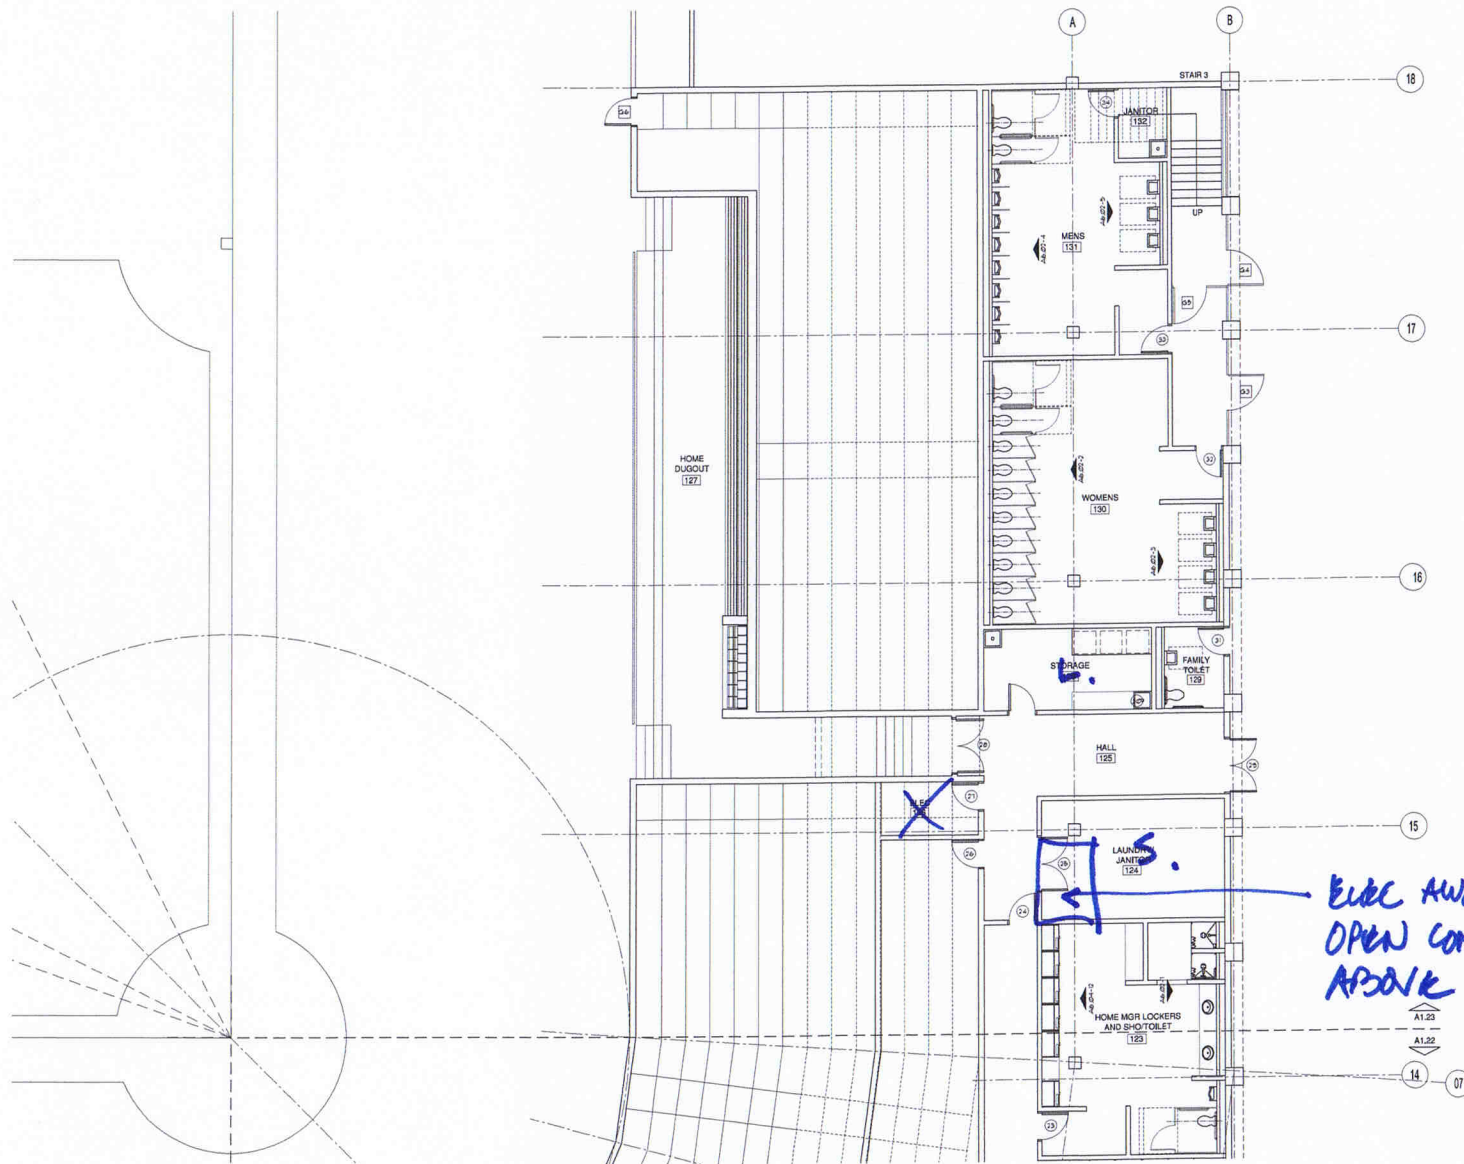


A1.10 FIELD LEVEL PART PLAN C
3/16" = 1'-0"

0 2 4 8 16
SCALE: 3/16" = 1'-0"

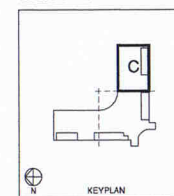

PROGRESS SET 03.22.16

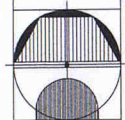

Steven E. Hutchins AIA Architects
109-113 ESTATE CASTLE COAKLEY
CHRISTIANSTED, ST. CROIX
U.S. VIRGIN ISLANDS 00822
TEL. 340-778-8888 FAX 340-778-7754

PROJECT:
FREDERIKSTED REVITALIZATION PROJECT
PAUL E. JOSEPH BASEBALL STADIUM
AND SPORT COMPLEX


DRAWING INFORMATION
FIELD LEVEL PART PLAN 'C'

DATE:
DRAWN BY:

SHEET NUMBER:



A1.23

3 OF 10

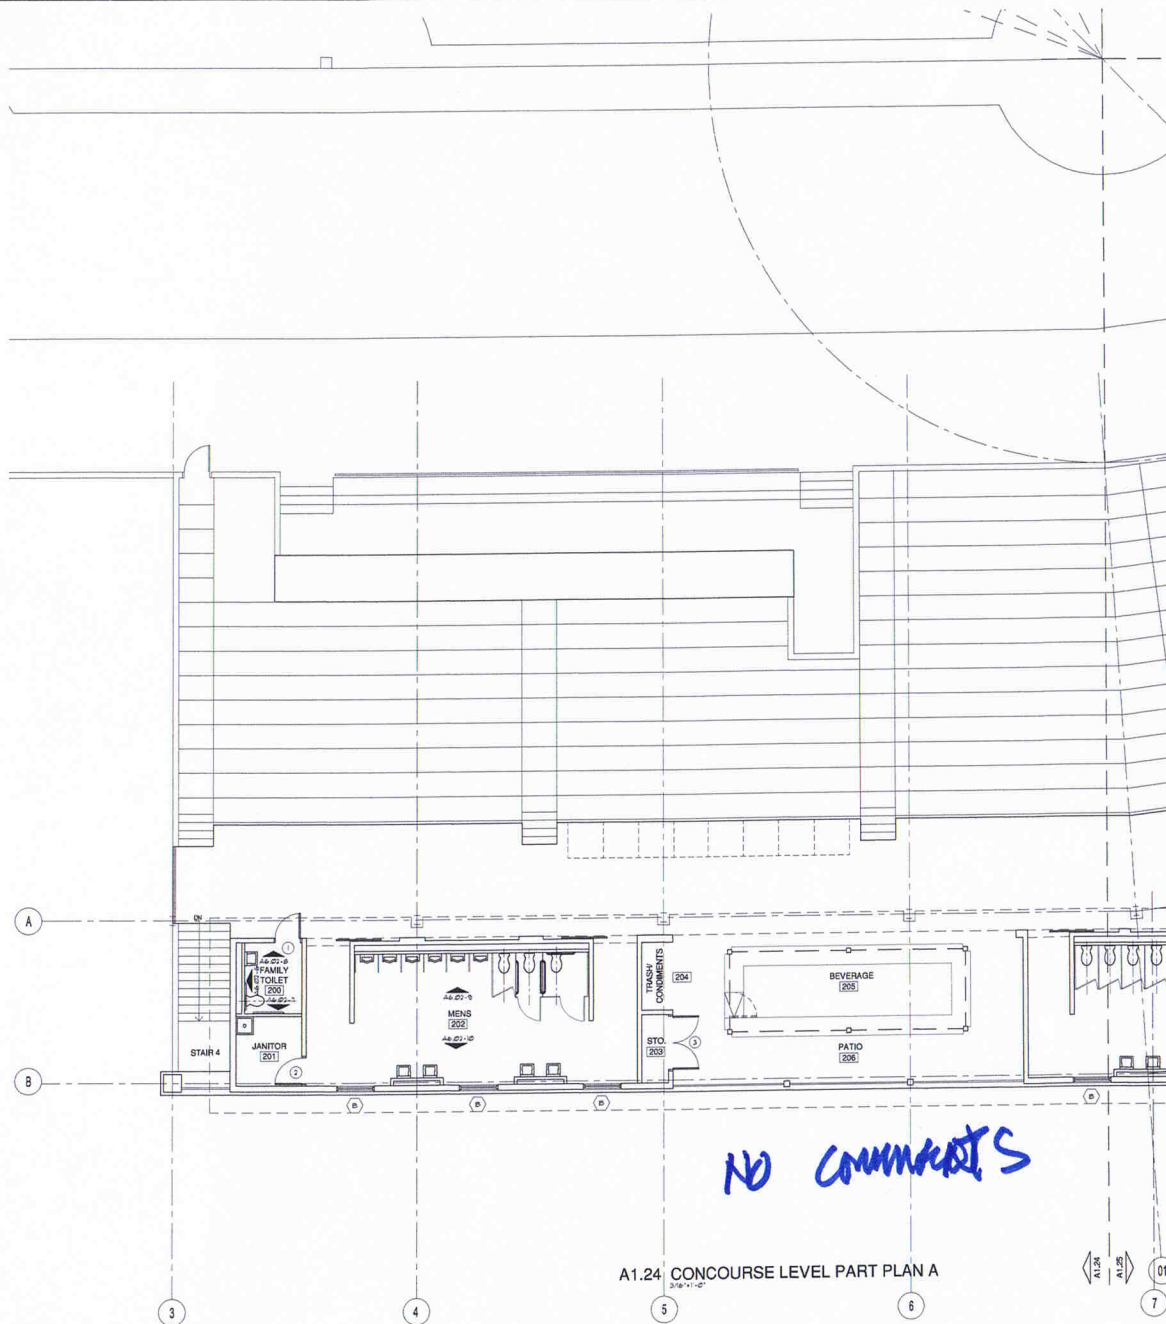

A1.24 CONCOURSE LEVEL PART PLAN A
3/16" = 1'-0"

0 2 4 6 8 10
SCALE: 3/16" = 1'-0"

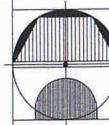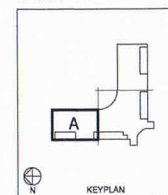

Steven E. Hutchins AIA Architects
109-113 ESTATE CASTLE COAKLEY
CHRISTIANSTED, ST. CROIX
U.S. VIRGIN ISLANDS 00822
TEL 340-778-5888 FAX 340-778-7754

PROJECT
FREDERIKSTED REVITALIZATION PROJECT
PAUL E. JOSEPH BASEBALL STADIUM
AND SPORT COMPLEX

CONCOURSE LEVEL PART PLAN 'A'


DATE:
DRAWN BY:

SHEET NUMBER:

A1.24

PROGRESS SET 03.22.16


4 of 10

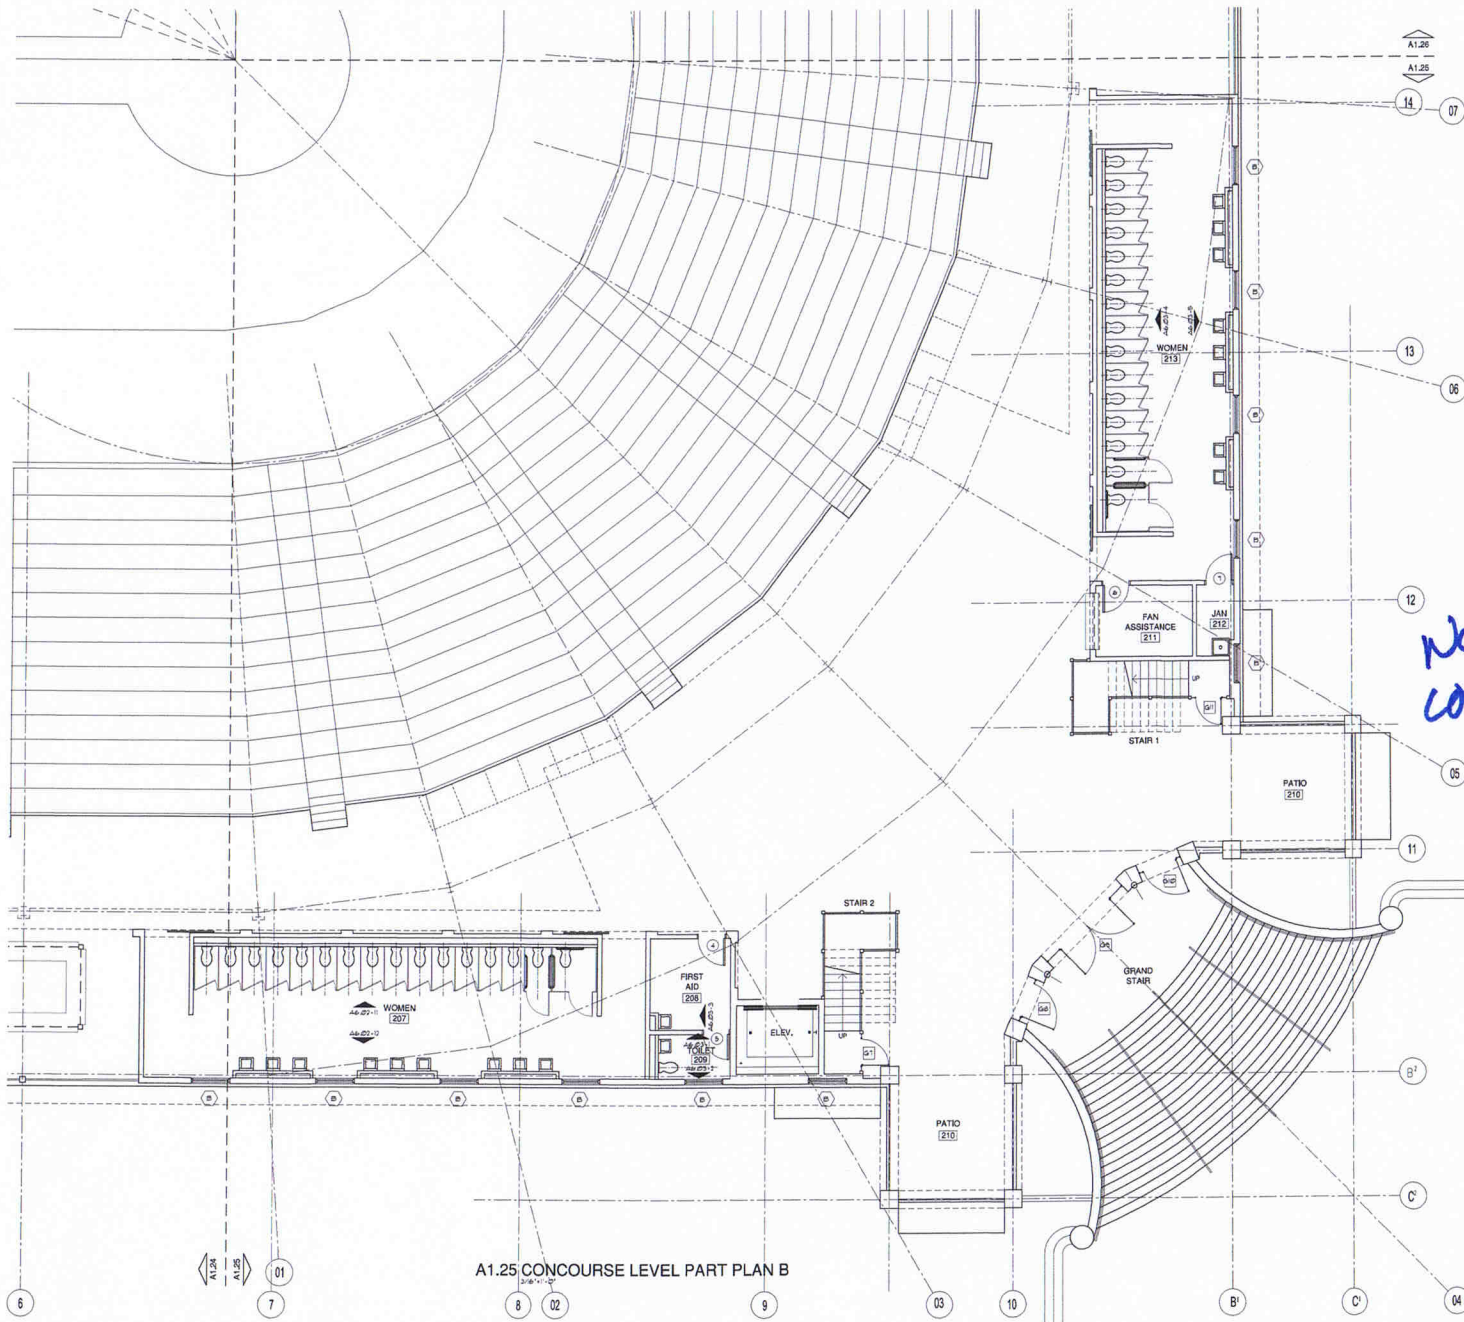

A1.25 CONCOURSE LEVEL PART PLAN B

*NO
COMMENTS*

0 2 4 8 16
SCALE: 3/16" = 1'-0"

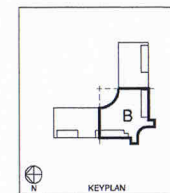

PROGRESS SET 03.22.16

DRAWING INFORMATION:


CONCOURSE LEVEL PART PLAN 'B'

PROJECT:

FREDERIKSTED REVITALIZATION PROJECT
PAUL E. JOSEPH BASEBALL STADIUM
AND SPORT COMPLEX

Steven E. Hutchins AIA Architects

109-113 ESTATE CASTLE CORALEY
CHRISTIANSTED, ST. CROIX
U.S. VIRGIN ISLANDS 00822
TEL. 340-778-8888 FAX 340-778-7754

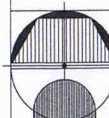


DATE:

DRAWN BY:

SHEET NUMBER:



A1.25

5 of 10

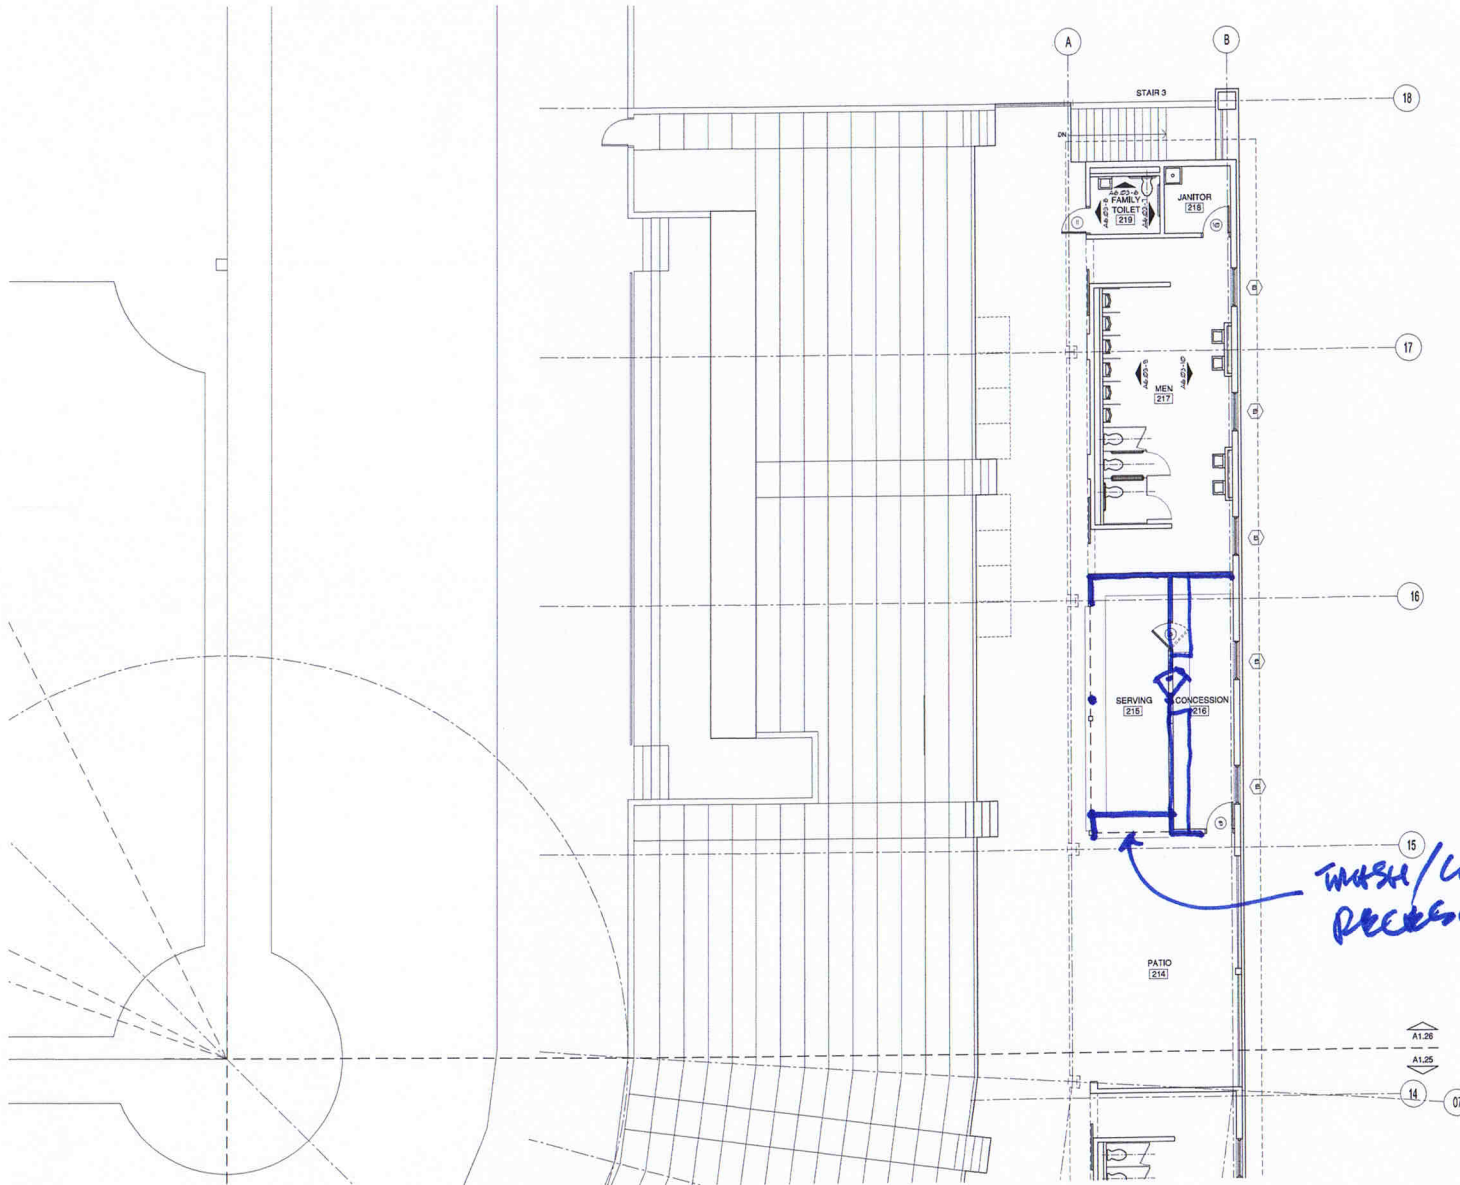

A1.26 CONCOURSE LEVEL PART PLAN C
3/16" = 1'-0"

0 2 4 8 16
SCALE: 3/16" = 1'-0"

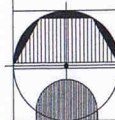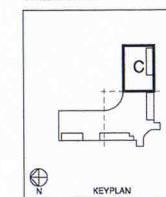

Steven E. Hutchins AIA Architects
109-113 ESTATE CASTLE COAKLEY
CHRISTIANSTED, ST. CROIX
U.S. VIRGIN ISLANDS 00822
TEL 340-778-8888 FAX 340-778-7754

PROJECT:
FREDERIKSTED REVITALIZATION PROJECT
PAUL E. JOSEPH BASEBALL STADIUM
AND SPORT COMPLEX

DRAWING INFORMATION:
CONCOURSE LEVEL PART PLAN 'C'



DATE:
DRAWN BY:

SHEET NUMBER:

A1.26

PROGRESS SET 03.22.16

6 OF 10

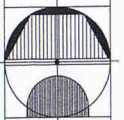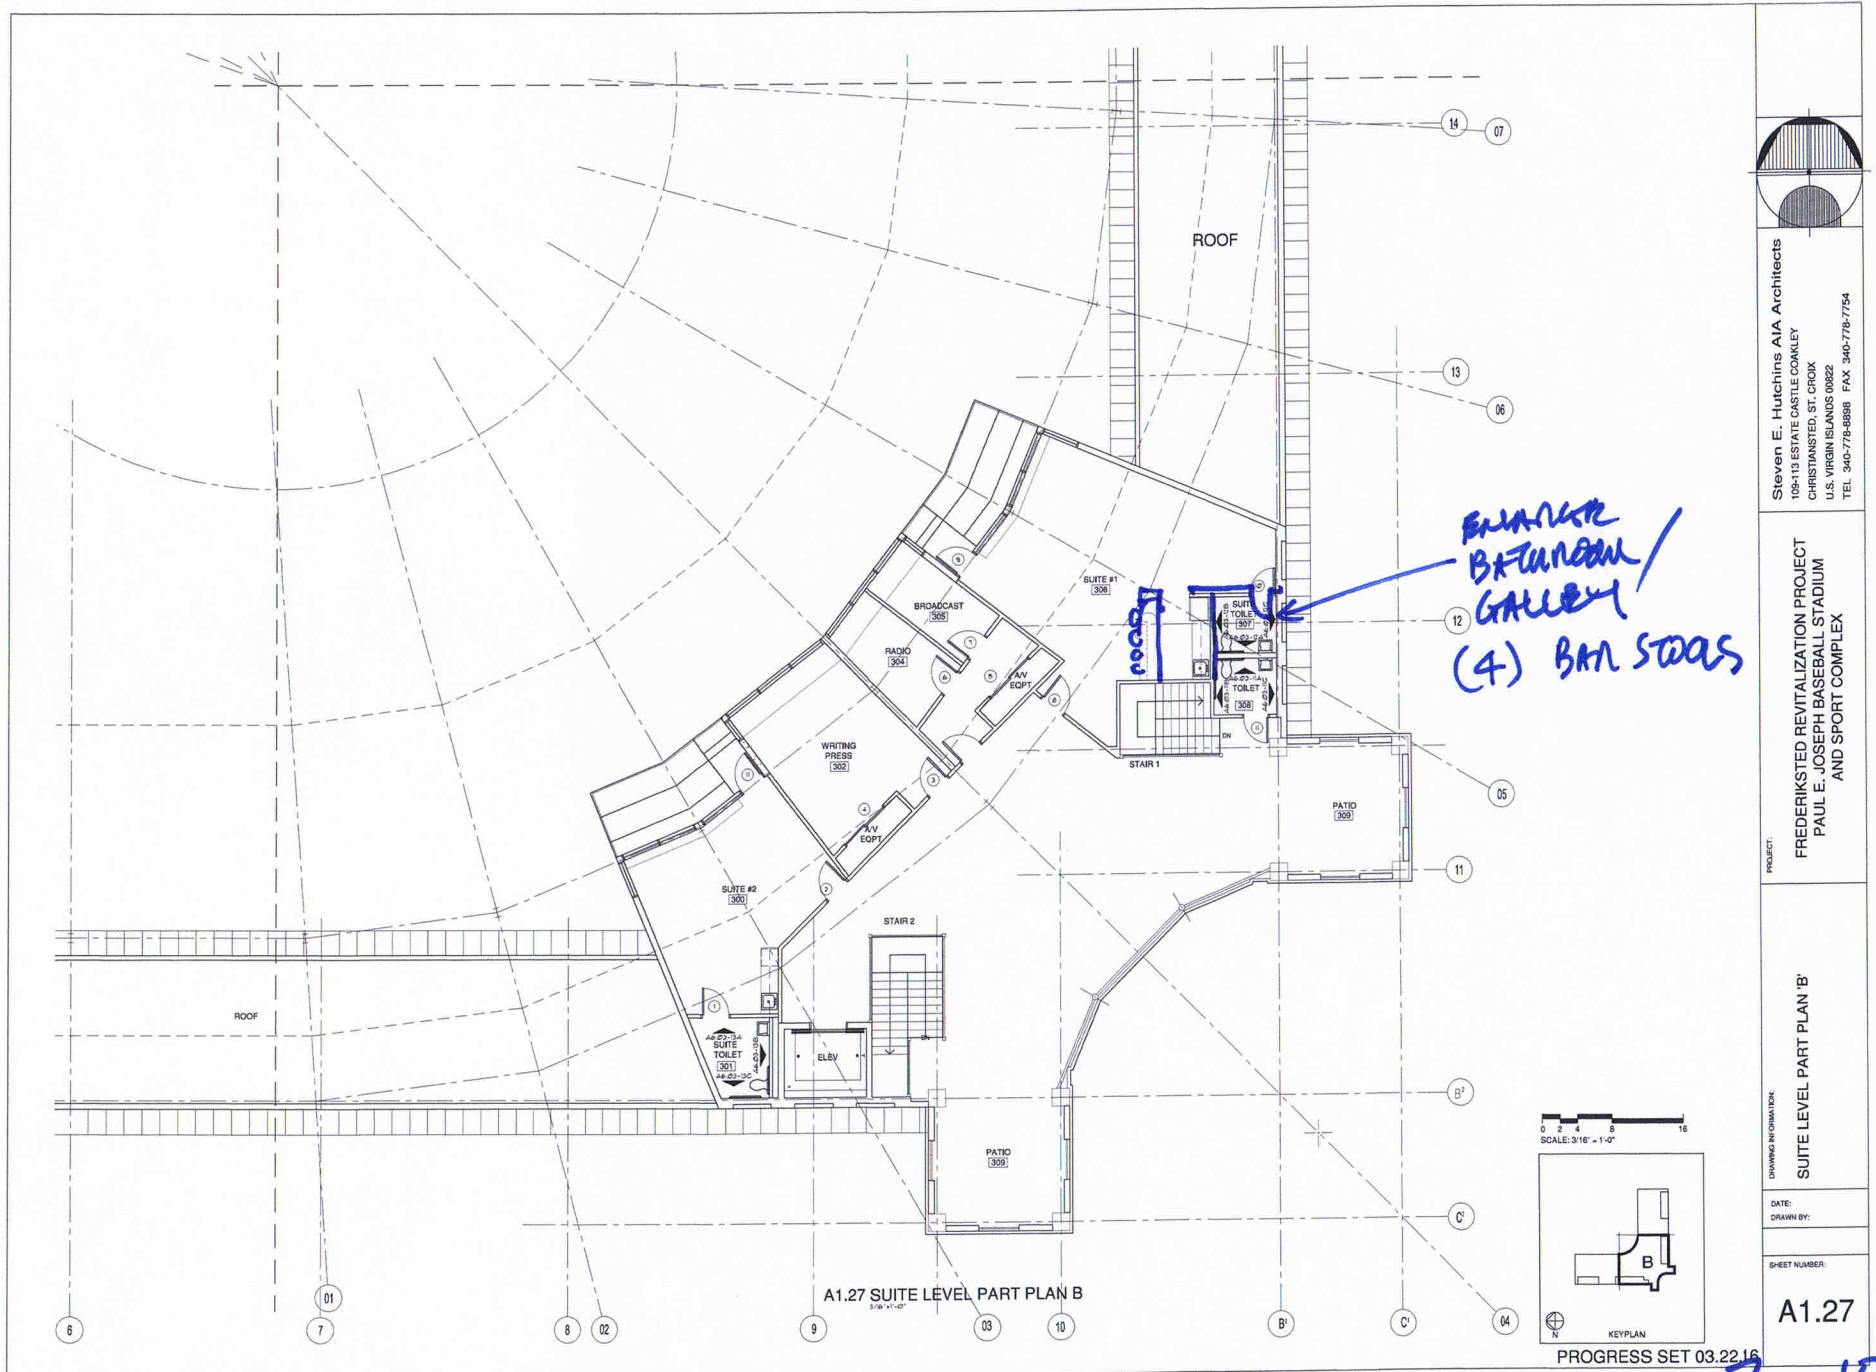

Steven E. Hutchins AIA Architects
109-113 ESTATE CASTLE COAKLEY
CHRISTIANSTED, ST. CROIX
U.S. VIRGIN ISLANDS 00822
TEL 340-778-8888 FAX 340-778-7754

PROJECT:
FREDERIKSTED REVITALIZATION PROJECT
PAUL E. JOSEPH BASEBALL STADIUM
AND SPORT COMPLEX


DRAWING IN CHARGE:
SUITE LEVEL PART PLAN 'B'

DATE:
DRAWN BY:

SHEET NUMBER:

A1.27

0 2 4 8 16
SCALE: 3/16" = 1'-0"

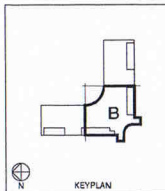


PROGRESS SET 03.22.16


7 OF 10

ROOF STUDY A-1


APPROVED EXISTING
(3) SIDED HIP.

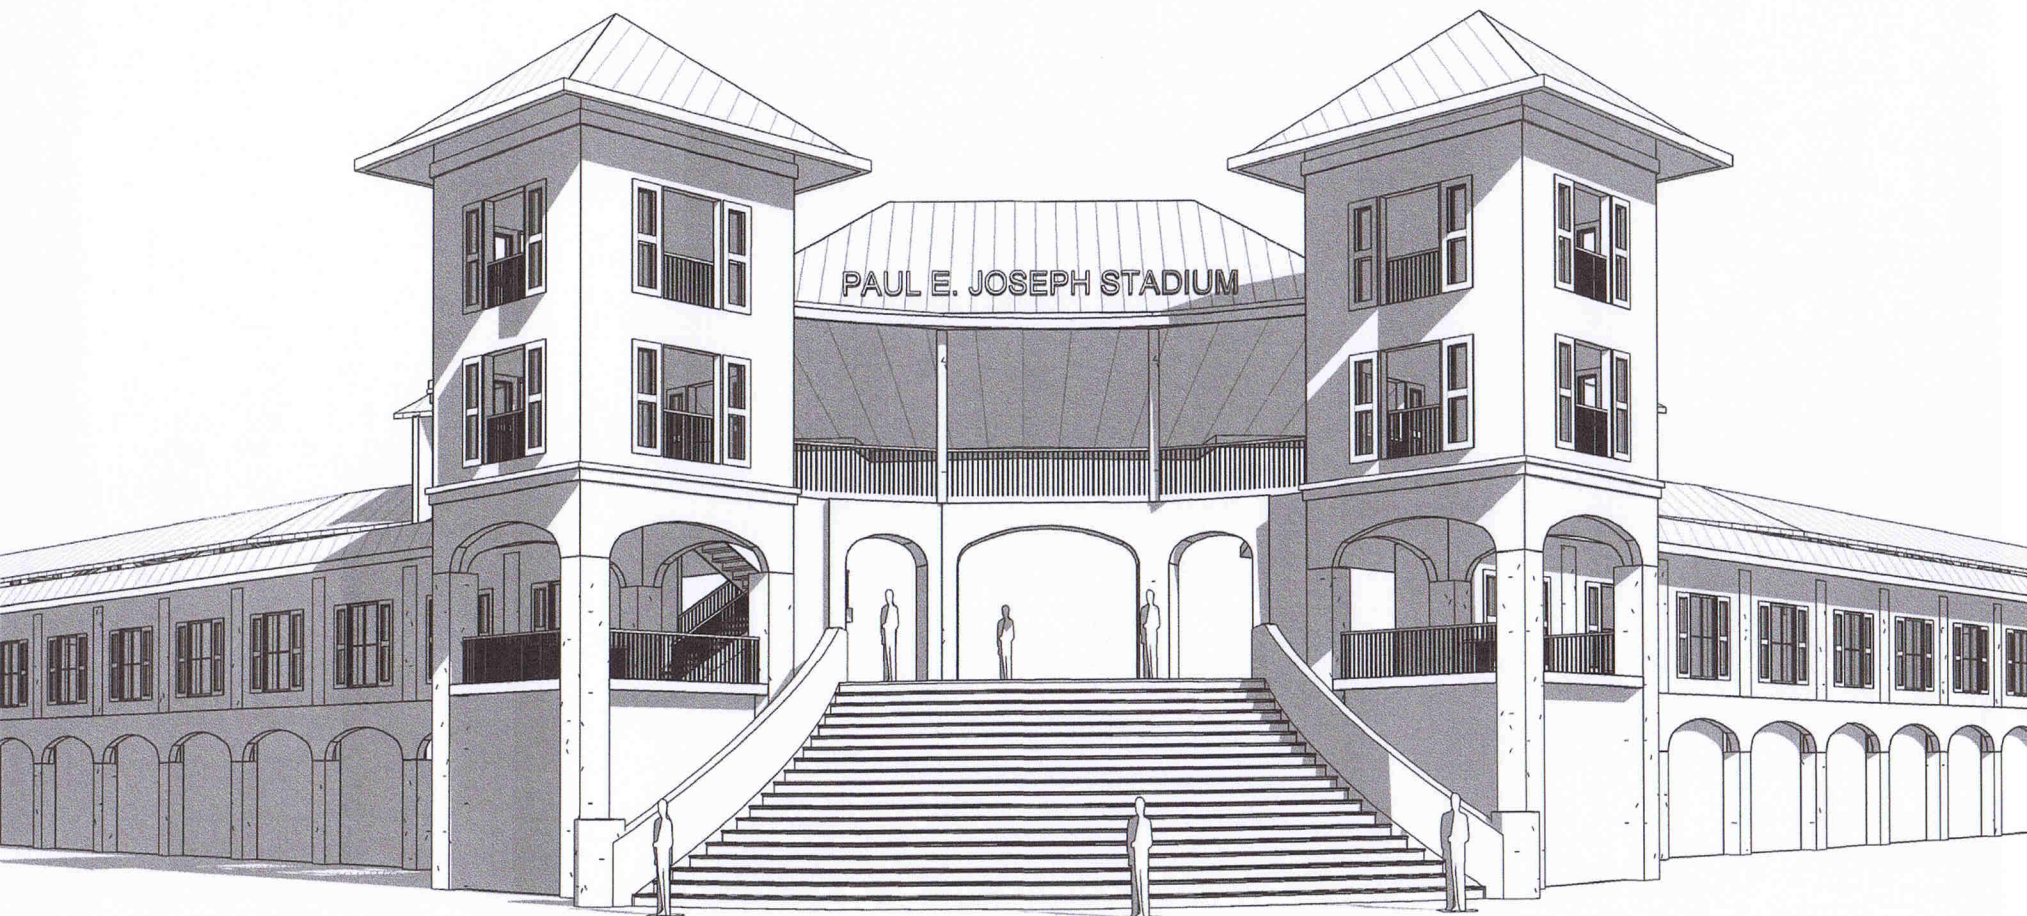

Steven E. Hutchins AIA Architects
P.O.Box 3493
CHRISTIANSTED, ST. CROIX
US VIRGIN ISLANDS 00822
340-778-8898 FAX 340-778-7754

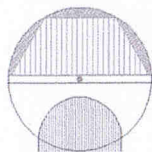


8 OF 10

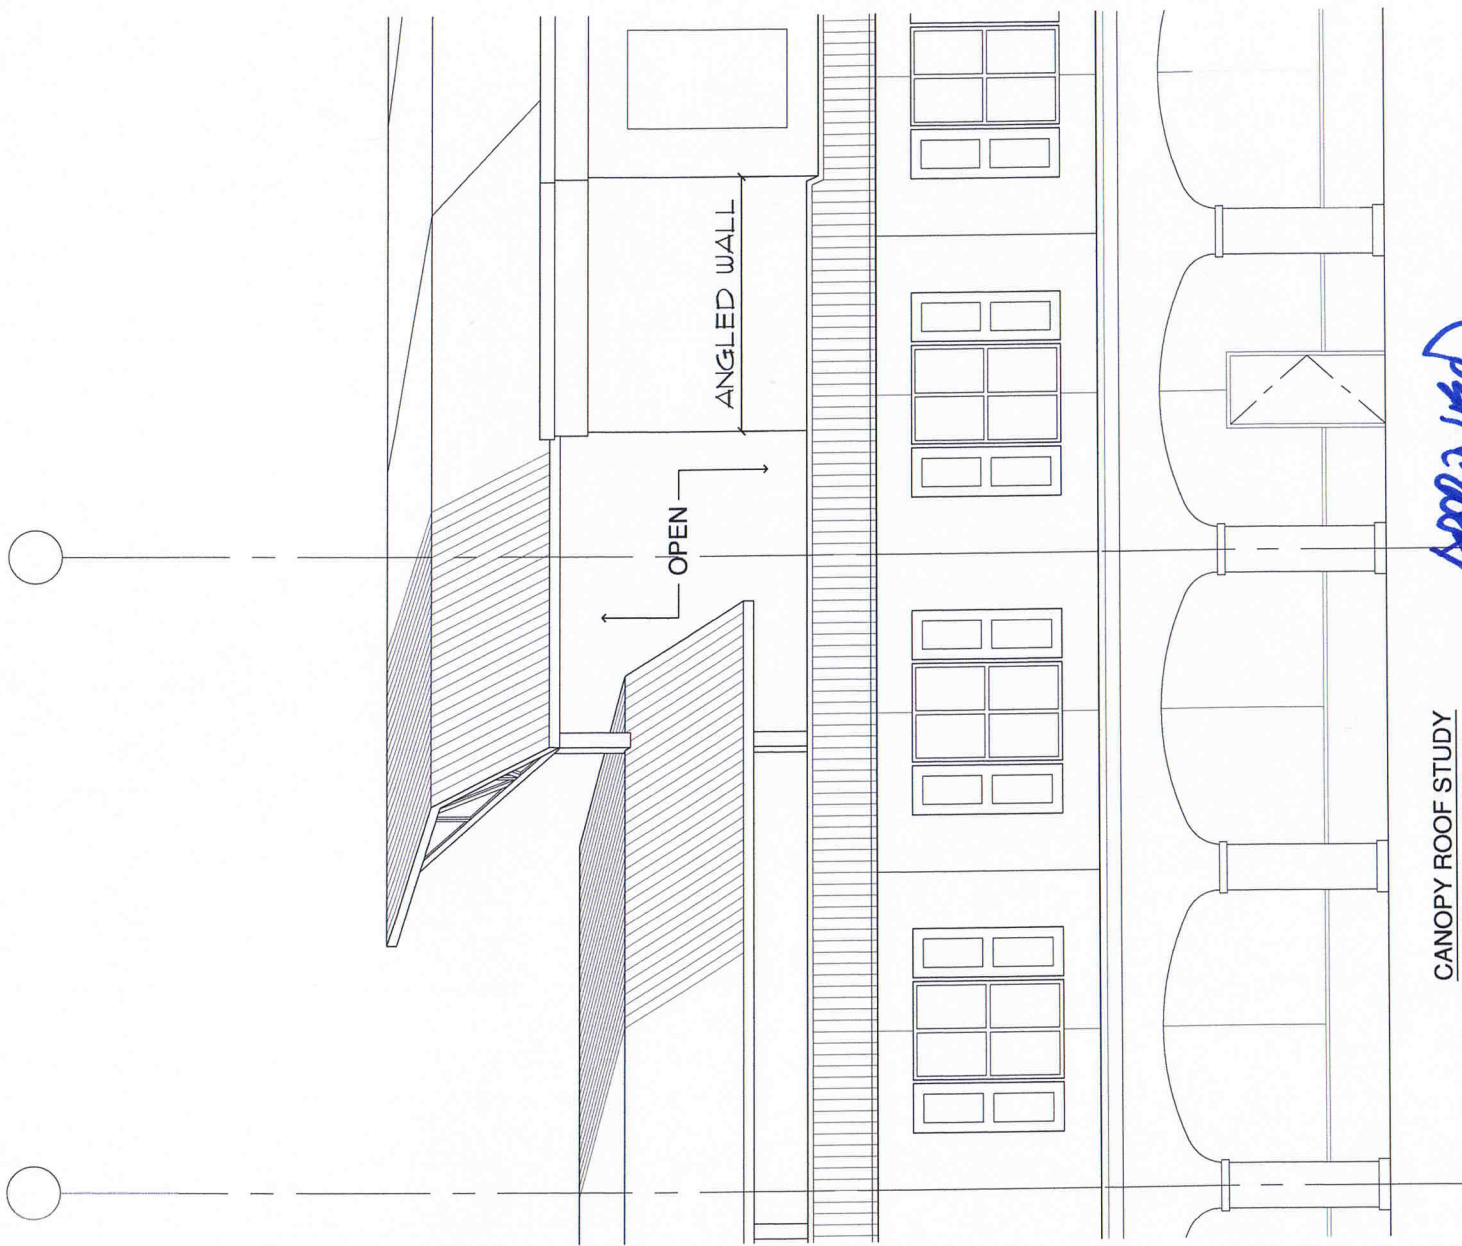


Approved

CANOPY ROOF STUDY
SCHEME A - 03.22.16

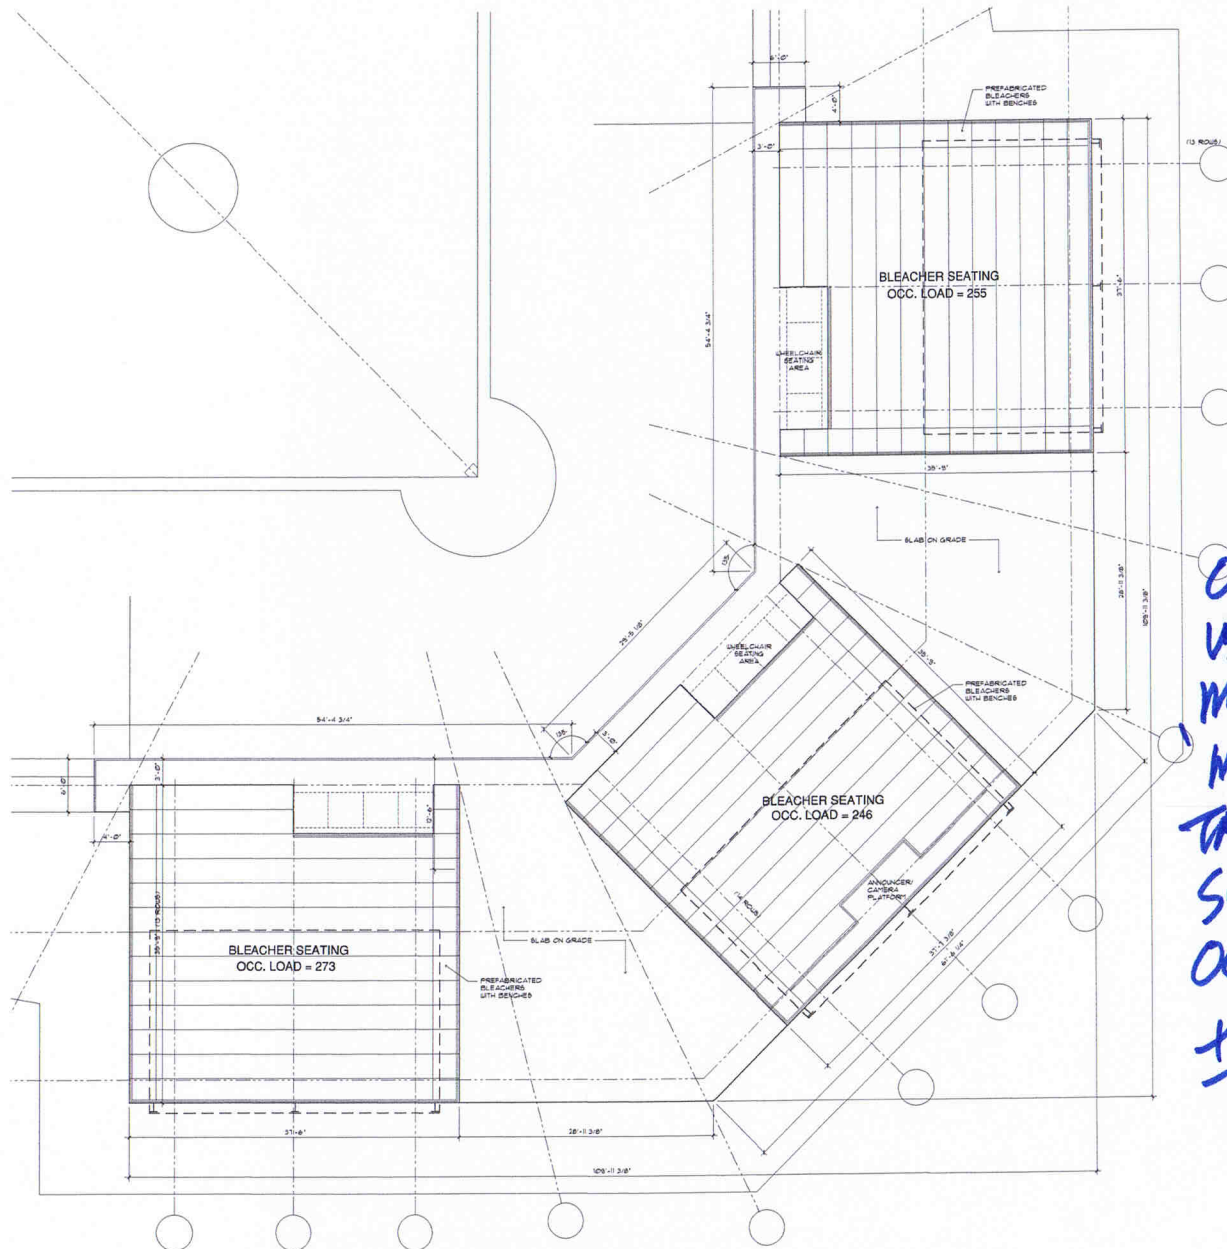

A9.01 SEATING LEVEL FLOOR PLAN
3/16/11

PROGRESS SET 03.22.16

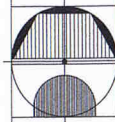

Steven E. Hutchins AIA Architects
109-113 ESTATE CASTLE COAKLEY
CHRISTIANSTED, ST. CROIX
U.S. VIRGIN ISLANDS 00822
TEL. 340-778-8898 FAX 340-778-7754

PROJECT:
FREDERIKSTED REVITALIZATION PROJECT
PAUL E. JOSEPH BASEBALL STADIUM
AND SPORT COMPLEX

DRAWING INFORMATION:
TERRENCE MARTIN FIELD
SEATING LEVEL FLOOR PLAN

DATE:
DRAWN BY:

SHEET NUMBER:

A9.01

100F10