


NATIONAL PARK SERVICES

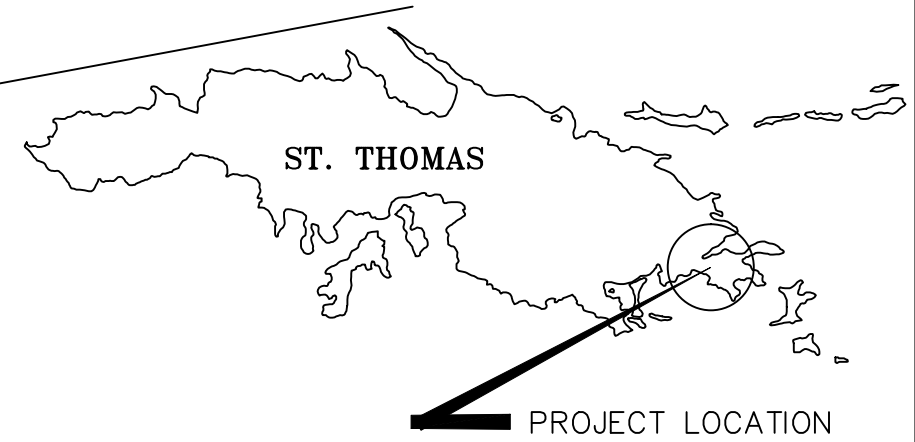

ST. THOMAS

PROJECT LOCATION

N79° 27'E
69.5'

L=76.9'
R=557.6'

RETAINING WALL

WOODEN DECK

POOL

BRICK DECK

PARCEL NO. 9A-7

WOODEN DECK

2 STORY
MASONRY STRUCTURE

PARCEL NO. 9A-6
0.40 Ac.±

ENCROACHING
CHAIN LINKED FENCE

TO: STREAMLINE TITLE AND ESCROW

THIS IS TO CERTIFY THAT THIS MAP OR PLAT AND THE SURVEY ON WHICH IT IS BASED WERE MADE IN ACCORDANCE WITH THE 2021 MINIMUM STANDARD DETAILS REQUIREMENTS FOR ALTA/ NSPS LAND TITLE SURVEY, JOINTLY ESTABLISHED AND ADOPTED BY ALTA AND NSPS, AND INCLUDED ITEMS: 1, 2, 4 AND 6 OF TABLE A THEREOF.

7-19-2025

DATE

Patrick Williams

SIGNED: PATRICK WILLIAMS, PE

CORR. W/ D9-293-T62

PARCEL NO. 9A-5

2'±

N3° 00'W

ENCROACHING
CHAIN LINKED FENCE

93.8'

15.0'±

WELL

SEPTIC
AREA

WOODEN DECK

POOL

BRICK DECK

PARCEL NO. 9A-7

WOODEN DECK

2 STORY
MASONRY STRUCTURE

PARCEL NO. 9A-6
0.40 Ac.±

ENCROACHING
CHAIN LINKED FENCE

TO: STREAMLINE TITLE AND ESCROW

THIS IS TO CERTIFY THAT THIS MAP OR PLAT AND THE SURVEY ON WHICH IT IS BASED WERE MADE IN ACCORDANCE WITH THE 2021 MINIMUM STANDARD DETAILS REQUIREMENTS FOR ALTA/ NSPS LAND TITLE SURVEY, JOINTLY ESTABLISHED AND ADOPTED BY ALTA AND NSPS, AND INCLUDED ITEMS: 1, 2, 4 AND 6 OF TABLE A THEREOF.

7-19-2025

DATE

Patrick Williams

SIGNED: PATRICK WILLIAMS, PE

LEGEND:

- △ UNMARKED POINT
- REBAR BOUNDPOST
- IRON PIPE BOUNDPOST FOUND
- ★ PK BOUNDPOST FOUND

REFERENCE:

D9-293-T62

ZONING: R-1: THIS PARCEL WAS CREATED PRIOR TO THE ZONING ORDINANCE OF 1972.

N3° 00'W
14.0'

FUEL

GEN.

STEPS

PLANTER

GATE

GATE

PLANTER

BRICK PARKING

PLANTER

1'±

13.6'±

145.2'

S7° 30'W

13.6'±

145.2'

S7° 30'W

8.0'


WALL

125'±

30' ESTATE ROAD R.O.W.

CONC. ROAD

CONC. ROAD

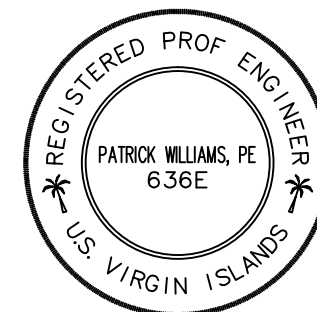

PATRICK WILLIAMS, PE
License: 636-E

ASBUILT SURVEY OF
PARCEL NO. 9A-6
ESTATE NAZARETH
NO. 1 RED HOOK QUARTER
ST. THOMAS, US VIRGIN ISLANDS

SURVEY : P.W.
SCALE : 1"=30'
DATE : 7-19-2025
REVISED : P.W.
DWG No.: 9A-6 NAZARETH

APPROVED :
Patrick Williams
OLG FILE No.