


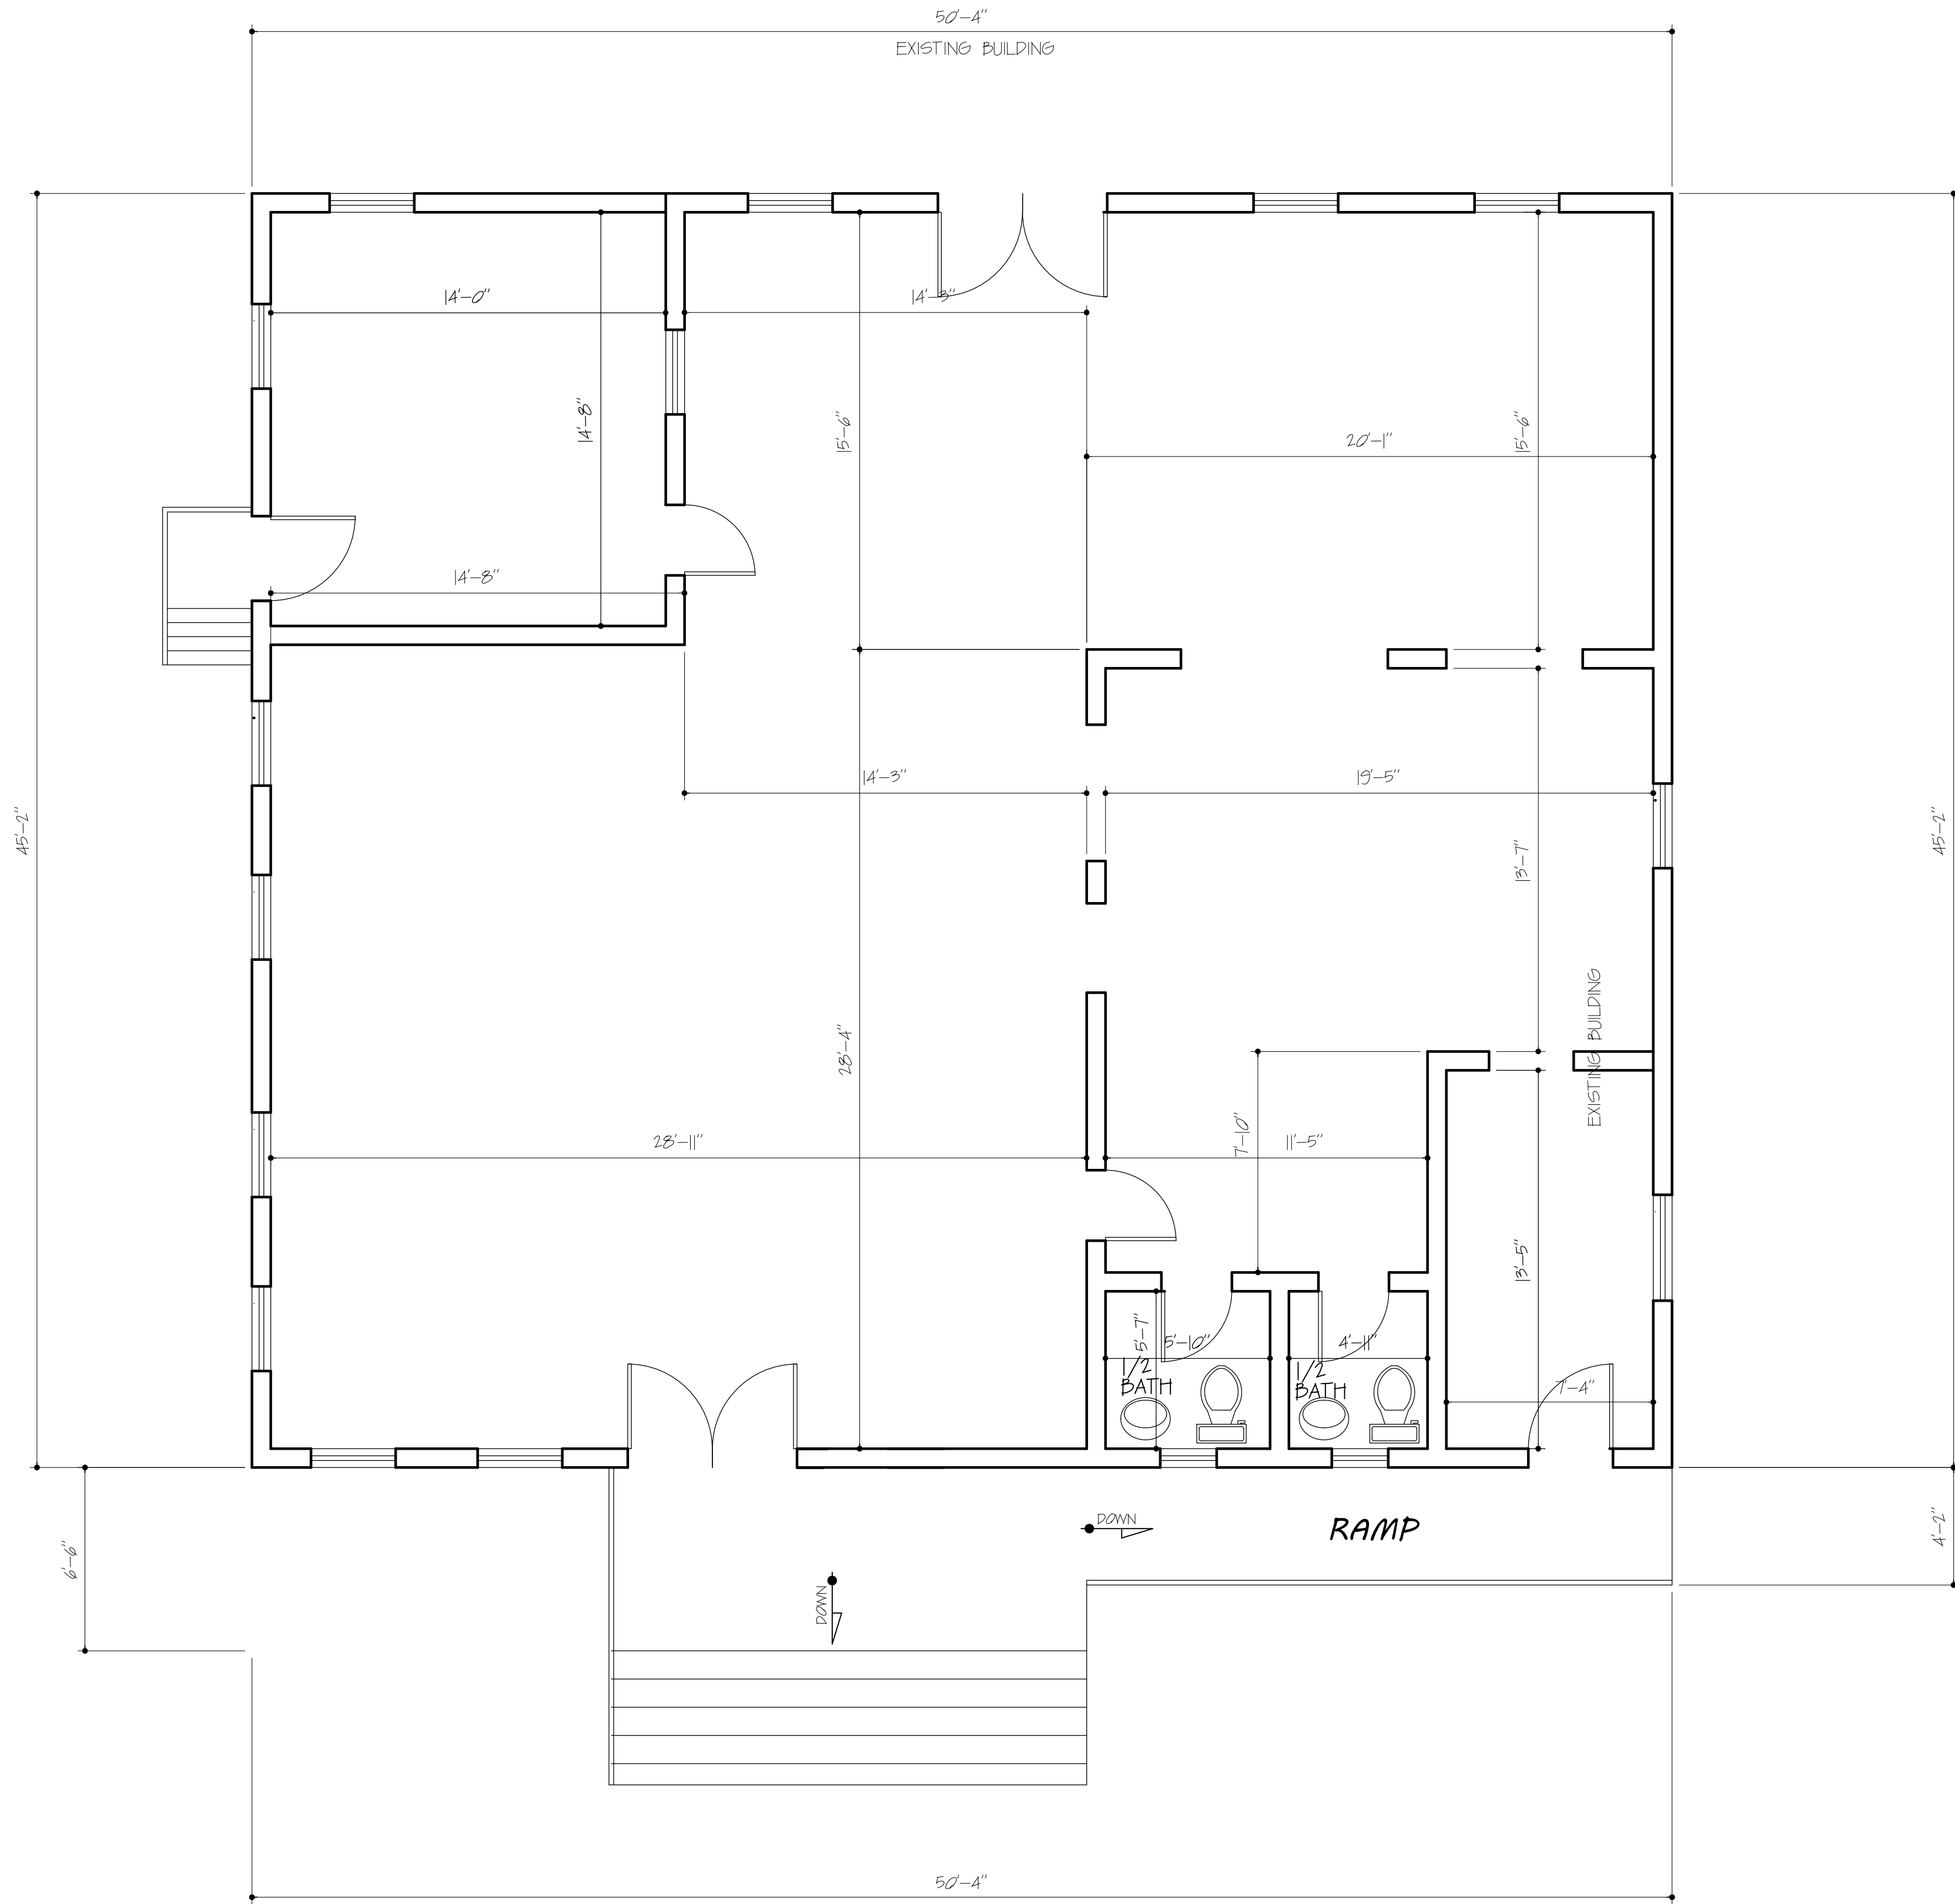

EXISTING FLOOR PLAN  
SCALE 1/4"=1'-0"

| EXISTING   |                    |
|------------|--------------------|
| AREA       | SIZE               |
| FLOOR AREA | 2273.99 square ft. |

| SAM GLOBE LTD.                                                                |              |                            |
|-------------------------------------------------------------------------------|--------------|----------------------------|
| PARCEL # 10 ESTATE PORTSBURG NO. 17A & 17B CORAL BAY QUARTER, ST. JOHN, USVI. |              |                            |
| SCALE: AS NOTED                                                               | APPROVED BY: | DRAWN BY: GODFREY MCLENNON |
| DATE: 06/05/2016                                                              |              | gworkofart@gmail.com       |
| EXISTING FLOOR PLAN                                                           |              |                            |
|                                                                               |              | DRAWING NUMBER<br>A-2      |