


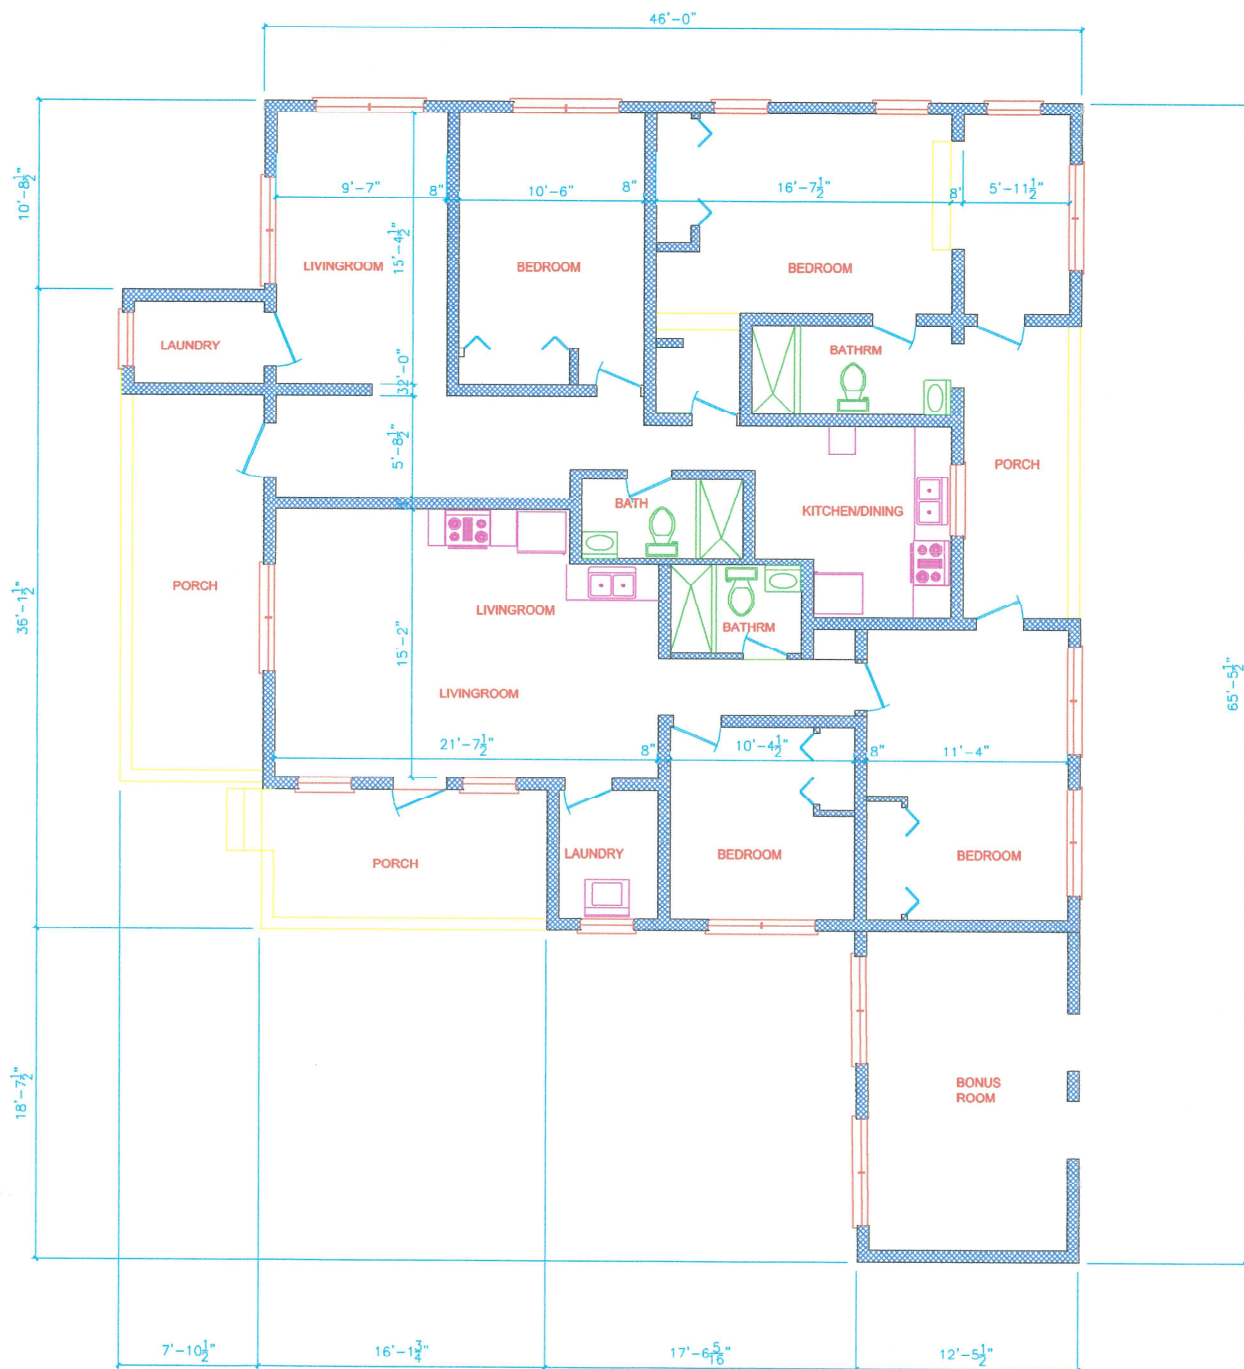

1 FLOOR PLAN

A1.1 A1.1 SCALE: 1/4"=1'-0"