


Existing Floorplan

Scale 3/16" = 1'

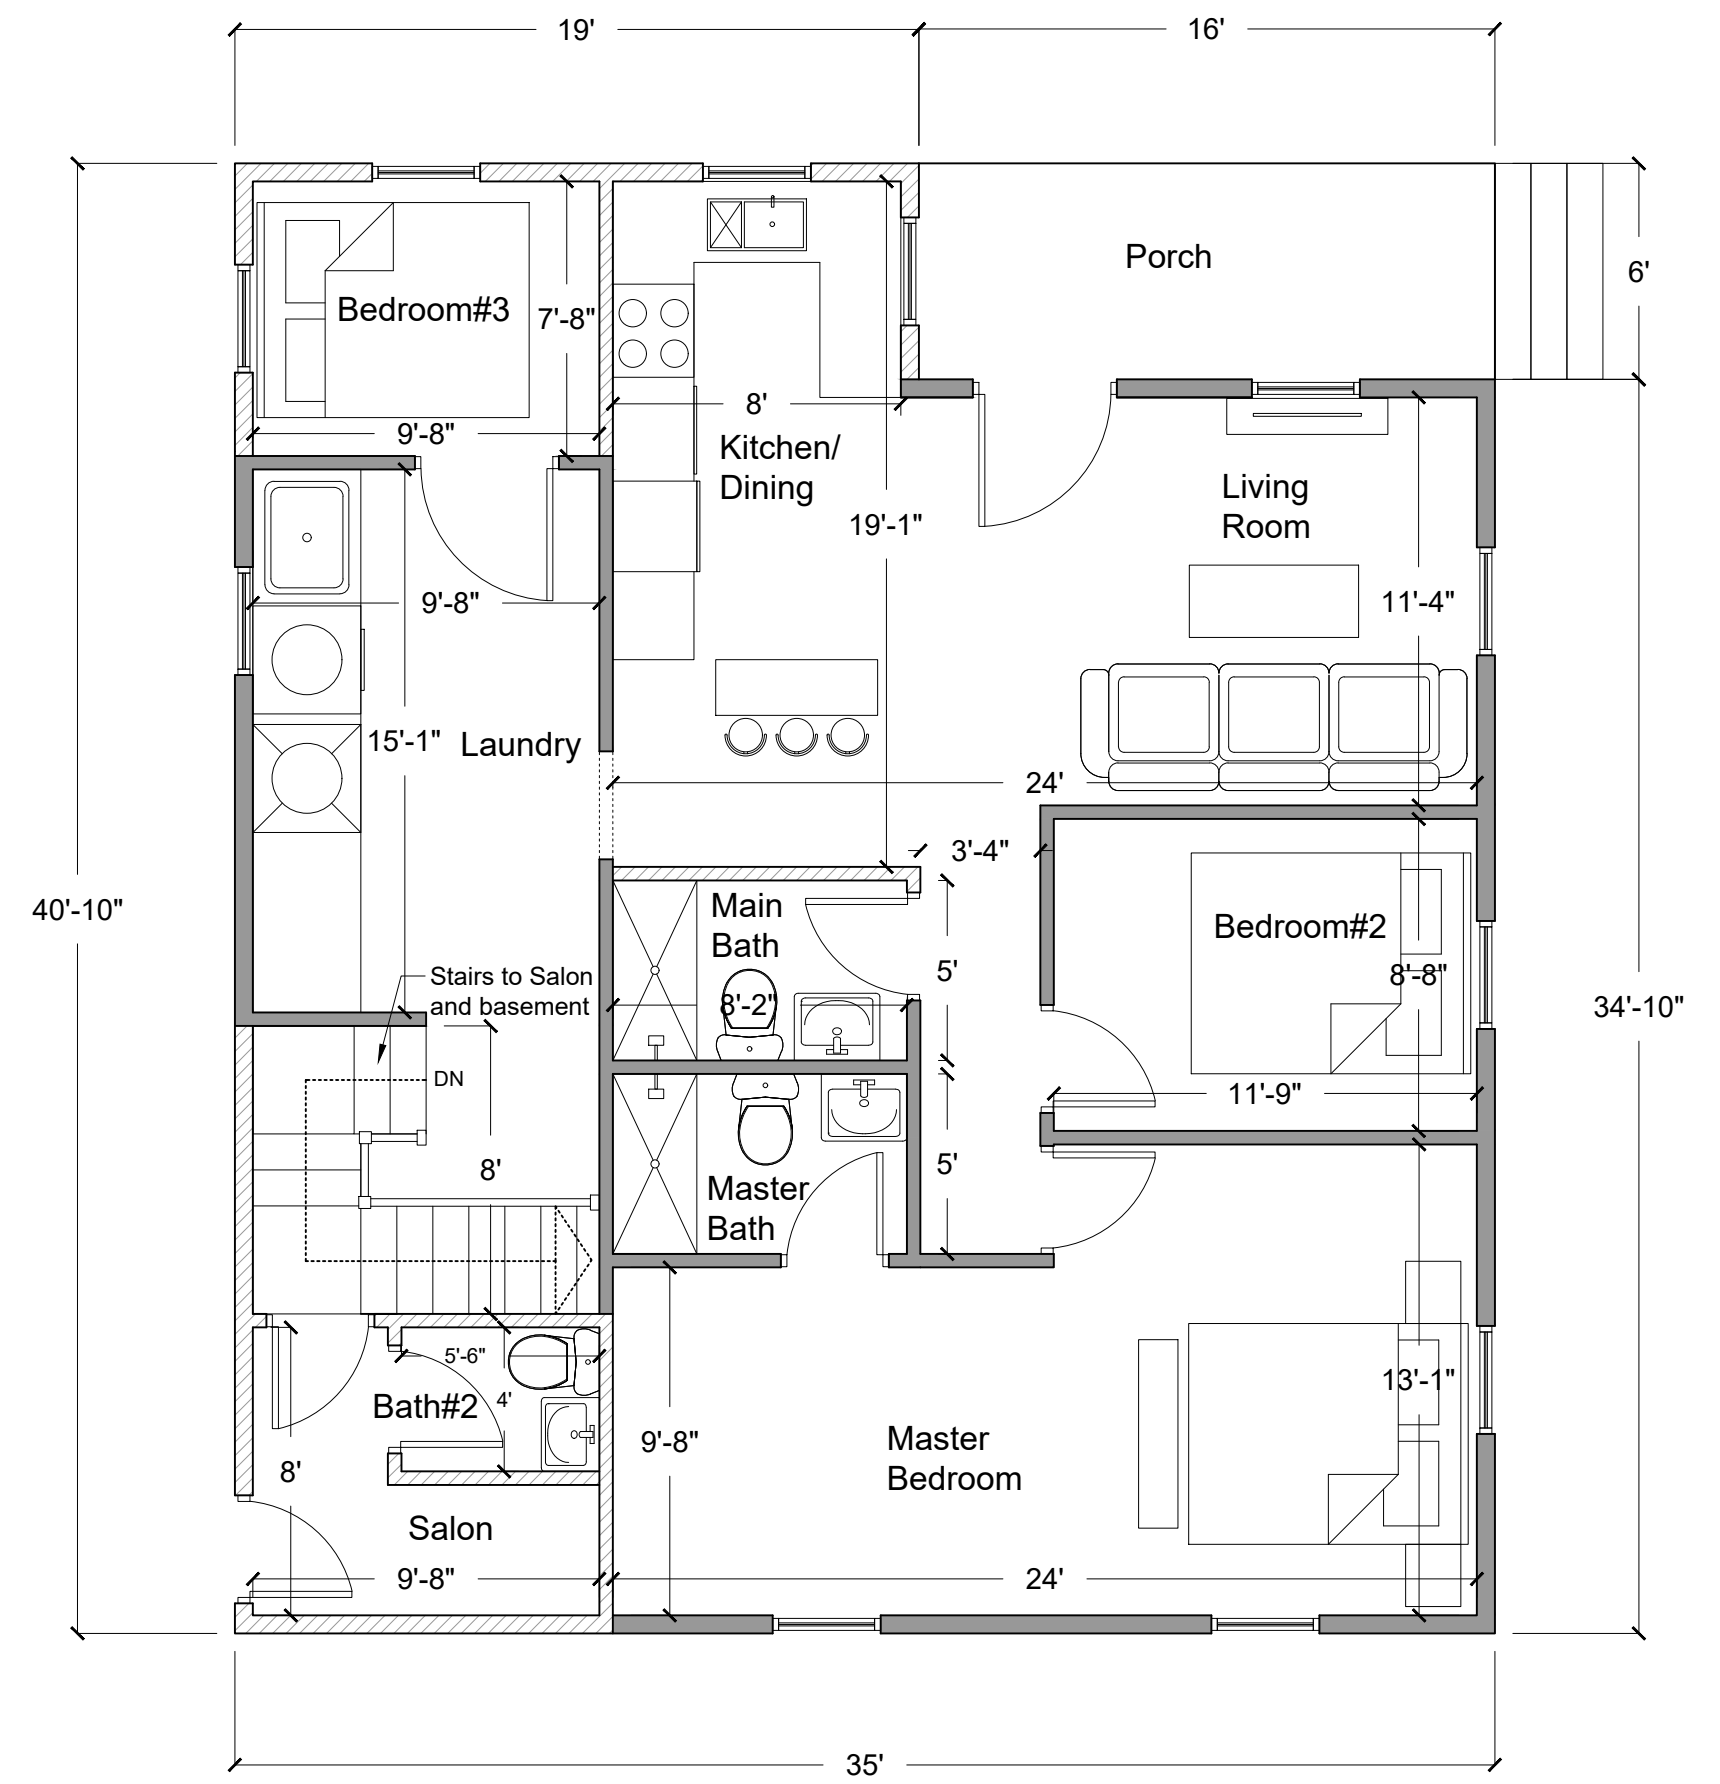

Proposed Floorplan

Existing Walls 

New Walls 