


Current Floor Plan - One Unit



Proposed Floor Plan for the Lower Level – 2 Units

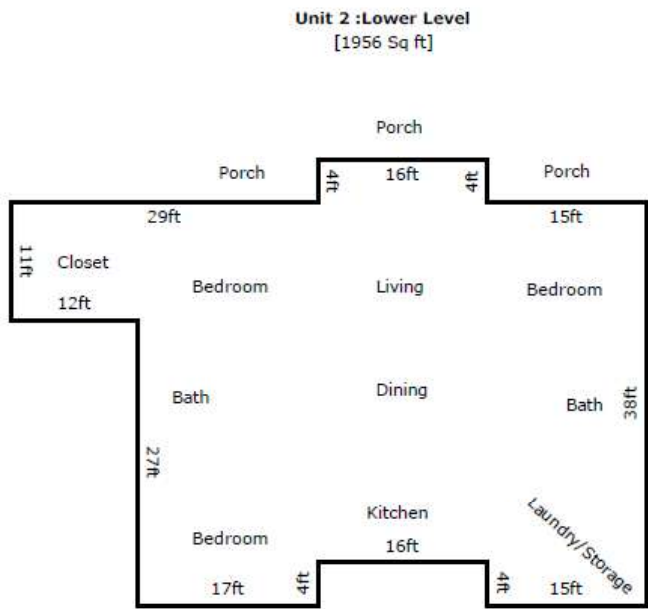