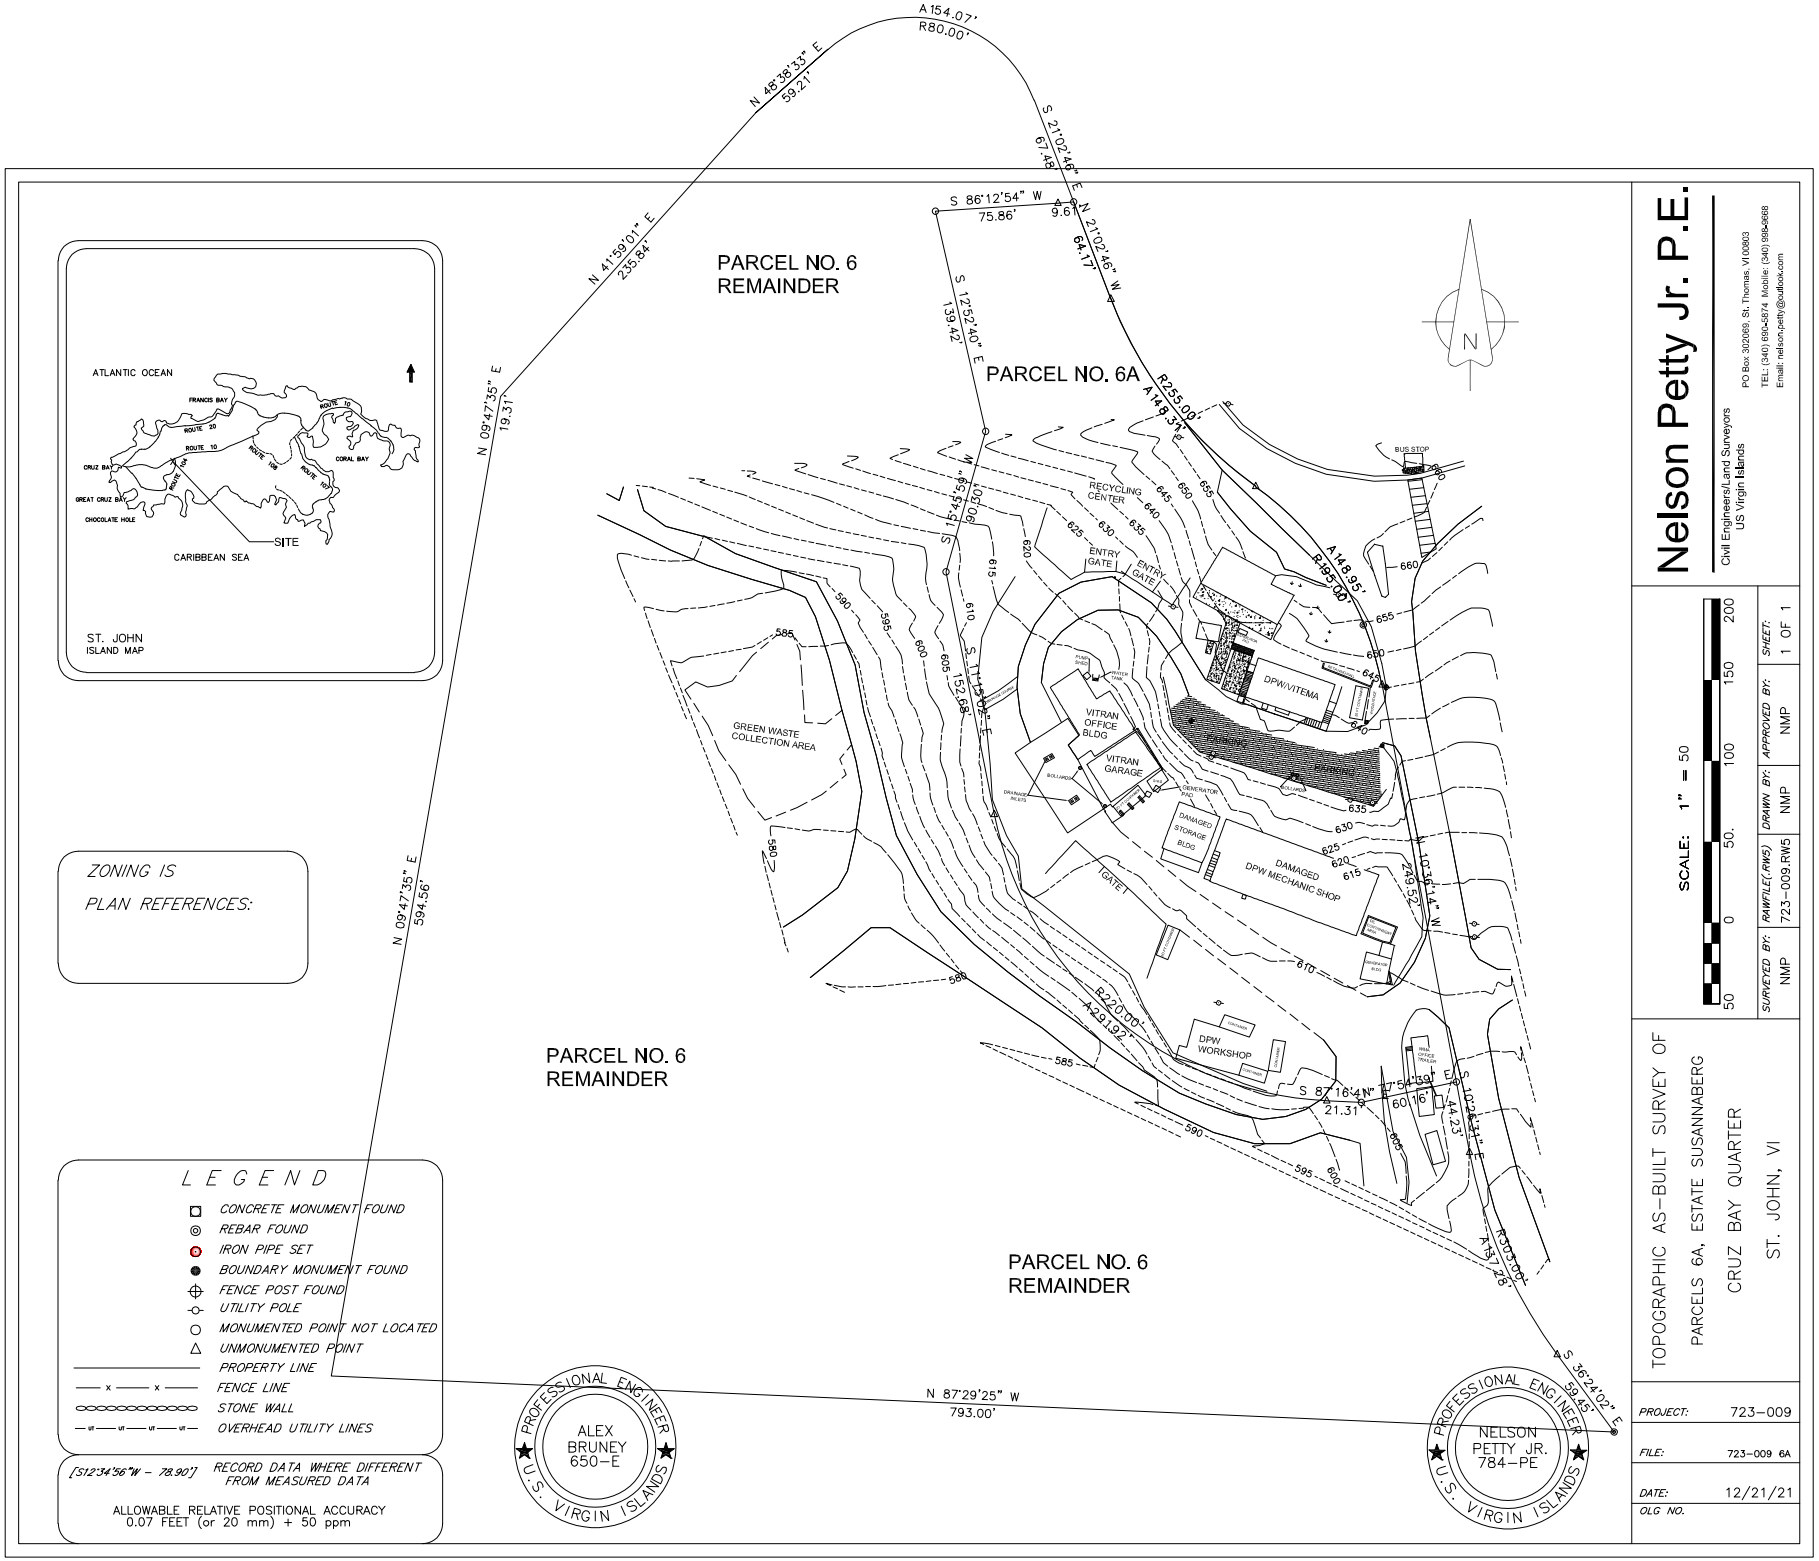

Nelson Petty Jr. P.E.

Civil Engineers/Land Surveyors
US Virgin Islands

PO Box 302069, St. Thomas, VI00803
TEL: (340) 690-5874 Mobile: (340) 998-9668
Email: nelson.petty@outlook.com

SCALE: 1" = 50

50 0 50 100 150 200

SURVEYED BY:	RAWFILE(.RW5)	DRAWN BY:	APPROVED BY:	SHEET:
NMP	723-009.RW5	NMP	NMP	1 OF 1

TOPOGRAPHIC AS-BUILT SURVEY OF
PARCELS 6A, ESTATE SUSANNABERG
CRUZ BAY QUARTER
ST. JOHN, VI

PROJECT:	723-009
FILE:	723-009 6A
DATE:	12/21/21
OLG NO.	