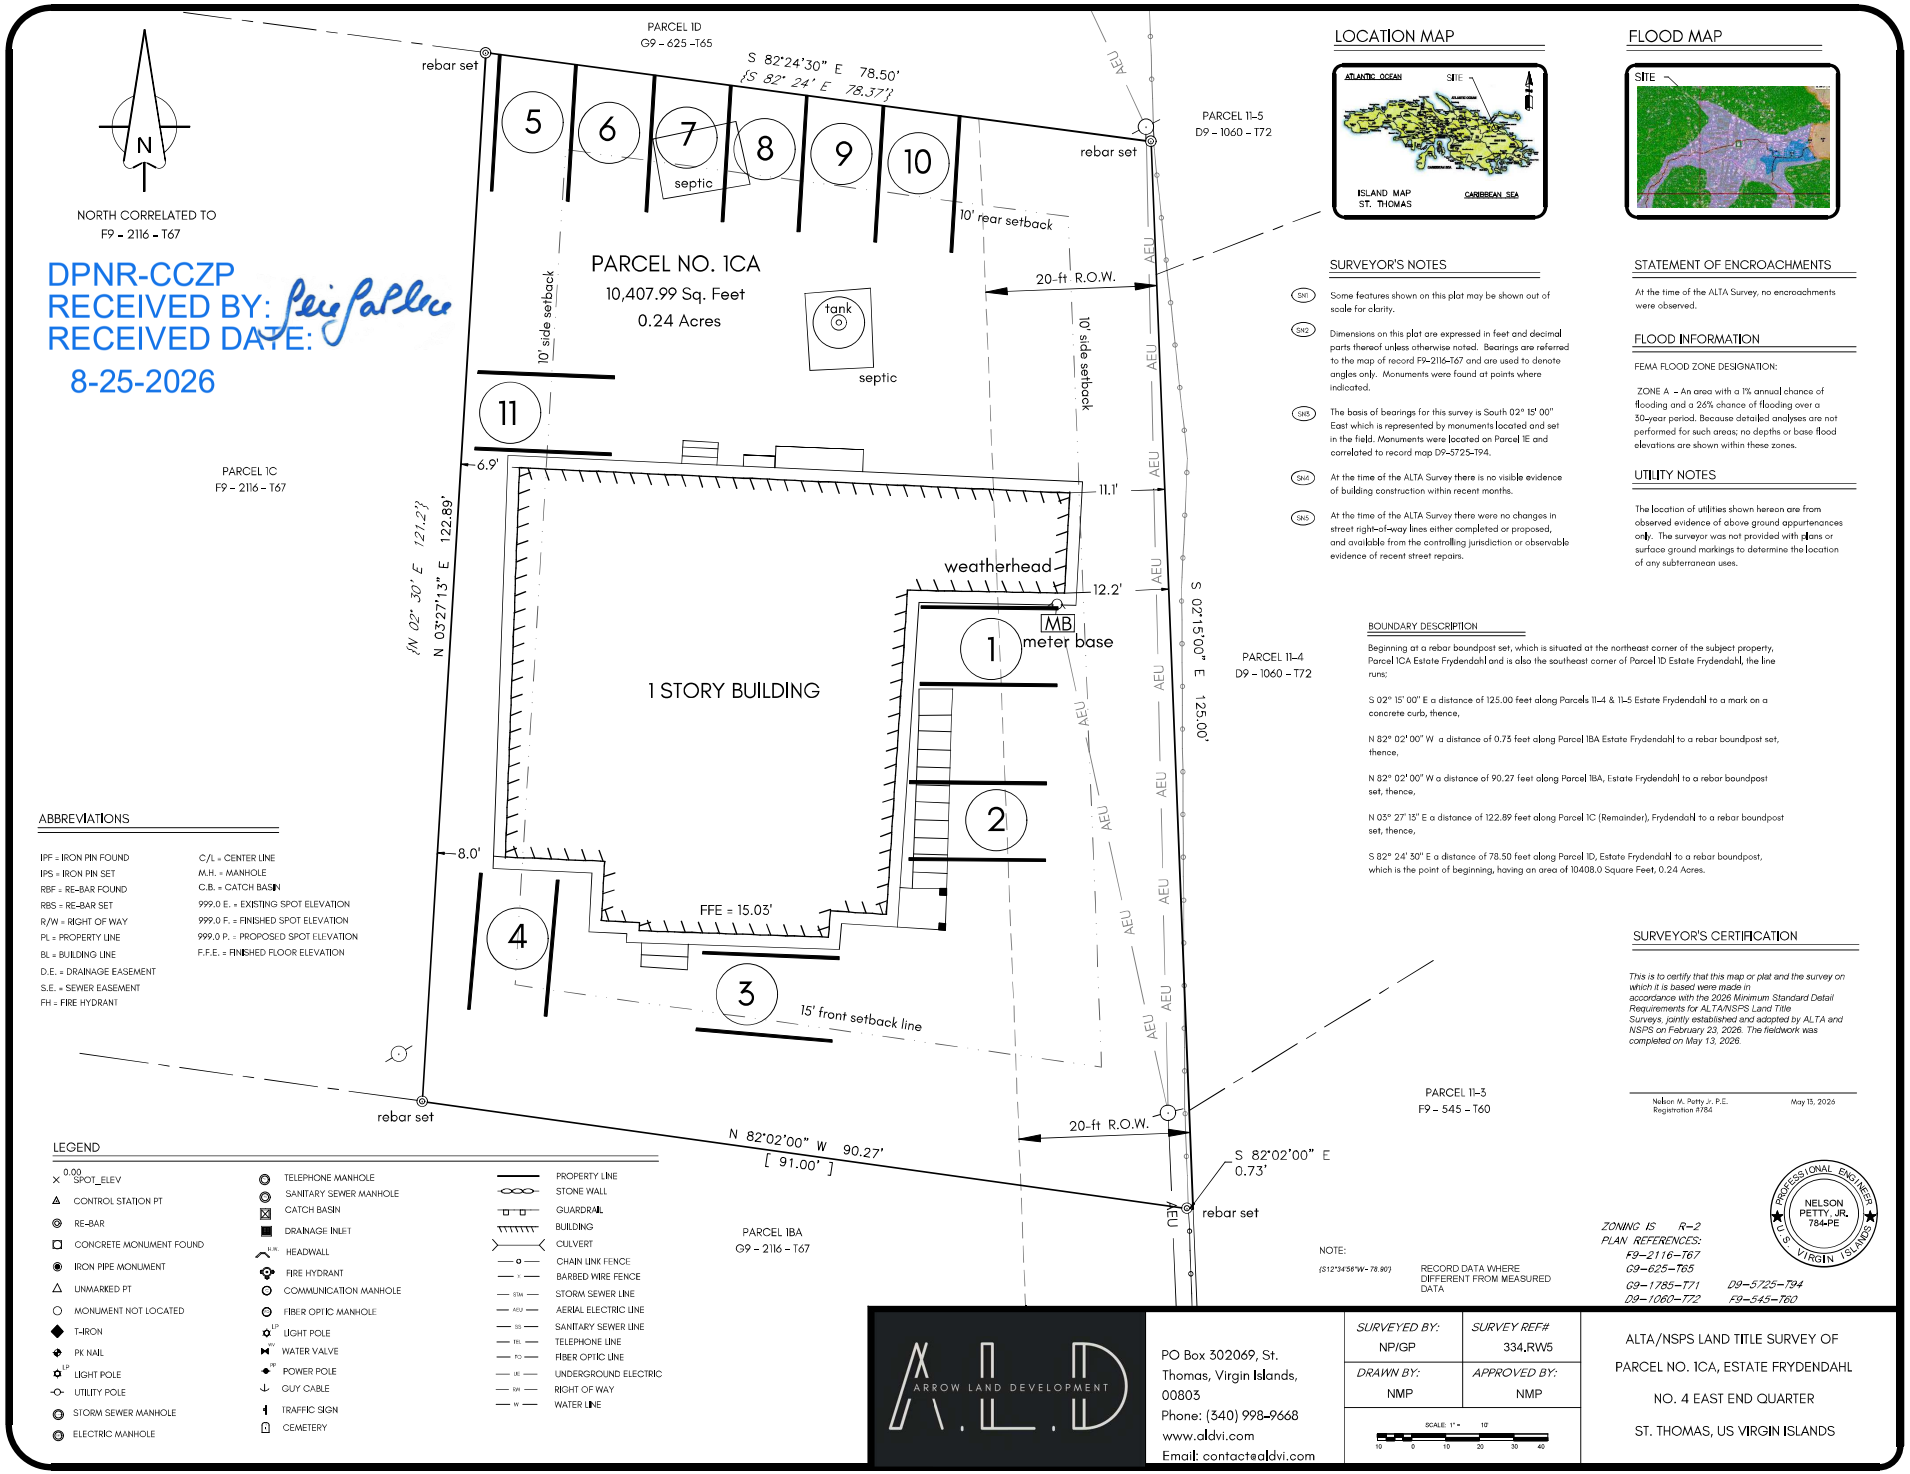

DPNR-CCZP
RECEIVED BY:
RECEIVED DATE:
8-25-2026

ARROW LAND DEVELOPMENT
PO Box 302069, St. Thomas, Virgin Islands, 00803
Phone: (340) 998-9668
www.aldvi.com
Email: contact@aldvi.com

SURVEYED BY:	SURVEY REF#
NP/GP	334.RW5
DRAWN BY:	APPROVED BY:
NMP	NMP

SCALE: 1" = 10'

ALTA/NSPS LAND TITLE SURVEY OF
PARCEL NO. 1CA, ESTATE FRYDENDAHL
NO. 4 EAST END QUARTER
ST. THOMAS, US VIRGIN ISLANDS